


Section 27 Township 15 Range 18W

Well No. #1 Gottschalk

Company Lebon Oil Prod.

NORTH

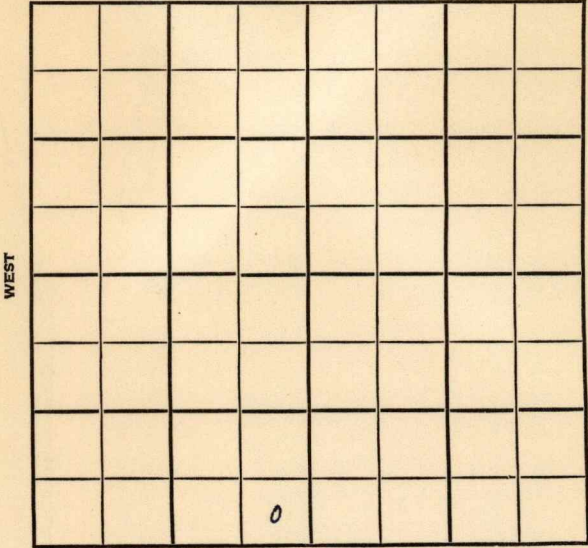

SOUTH


SEC.	TWP.	R.
27	15	18W

WELL NO. #1 Gottschalk FARM

COMPANY Lebon Oil Prod.

CONTRACTOR Co. Tools.  
Wildcat.

\_\_\_\_\_ Ft. from N. Line  
 330 \_\_\_\_\_ Ft. from S. Line  
 330 \_\_\_\_\_ Ft. from E. Line  
 \_\_\_\_\_ Ft. from W. Line

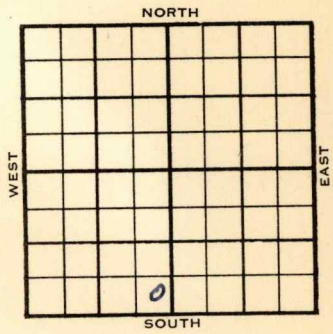

SE SE SW  
Phillips - DHM

1955 ELEVATION 1910' REPORT

3/23 Spud 3-18-55 .  
 4/13 Spud 3-18-55 D & A TD 3535  
 13-3/8" @ 200 8-5/8" @ 1064  
 Heeb 3154 Lans 3201  
 DST 3203-24 open 38 min, rec 10' mud.  
 Off  
 DST 3485-95 open 1/2 hr rec 5' mud 130#  
 Arb. 3508 TD 3535'  
 D & A

**ABANDONED**



