


Section 32 Township 14 Range 13-W

Well No. #3 Rogg

Company Chas Trapp

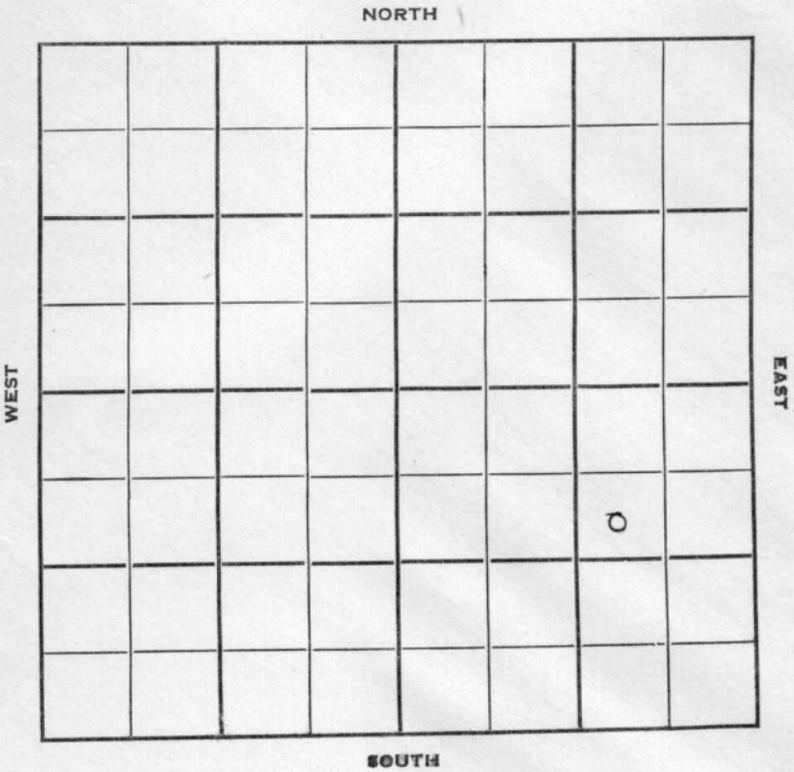

Sec. 32 Twp. 14 R. 13-W ✓

Well No. #3 Rogg Farm

Chas Trapp Company

Contractor

Hall-Gurney


990 Ft. from N. Line

_____ Ft. from S. Line

990 Ft. from E. Line

_____ Ft. from W. Line

SW NE SE

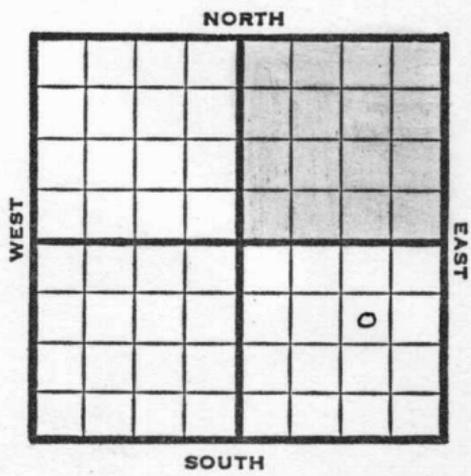

1950

Elev. 1703

REPORT

9/20

RUR

12/6

Spud 9-24-50
 Oil Well TD 2935'
 15" @ 62' 13" @ 230
 Anhy 645' 10" @ 655
 6" @ 2228' Tarkio 2233-58 TD
 F/2½ mcfg
 SSO DD 2294
 Est/4 bopd 3/4 cfgpd
 Lans. 2851' TD 2881'
 7" @ 2654'
 B/4 goph DD 2935 6000 A
 B/12 bopd SP 2865
 P/10 bopd 6000 A no inc.
 Comp. 10 bopd

COMPLETED


County Russell State Kansas

Sec. 32 (Blk. 14) (Sur. Rge.) 13W Map No.

Operator Chas Trapp

Well No. 3 Farm Rogg

Elev. _____ Location SW NE SE

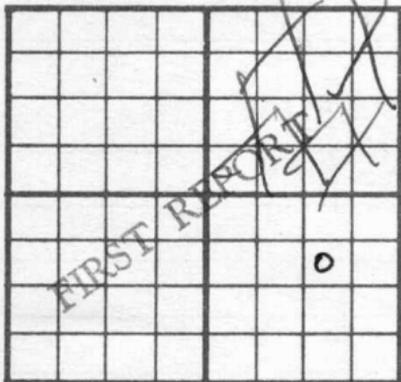

990 Ft. From N Line SE

990 Ft. From E Line Quarter

1st. Report SEP 20 1950

Completion _____

Remarks _____

Spudding Date _____

Drlg. Data Hall-Gurney Pool

RUR

J. E. TYRA

