

KANSAS


FORM 51 5M 1-42 PETROL

Saline

Section 20 Township 16 Range 1-W

Well No. #2 Norton

Company Deep Rock

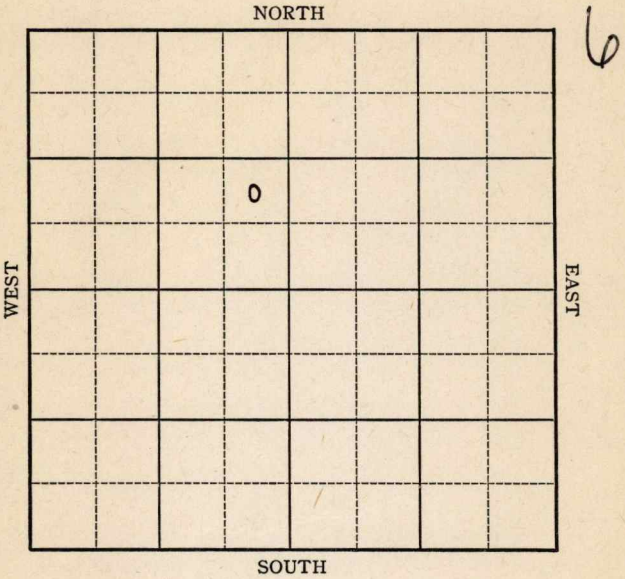

KANSAS

Saline

Sec. 20 Twp. 16 R. 1-W

Well No. #2 Norton Farm

Deep Rock Company


Hunter

 Ft. from N. Line

990 Ft. from S. Line

330 Ft. from E. Line

 Ft. from W. Line

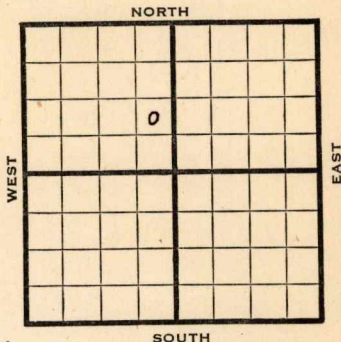

Elev. 1321

REPORT

1943

8/4 Location.

8/11 "

8/18 10" @ 130'
Drlg. 808'

8/25 Topeka 1525
Douglas 1853
Dodge 1970
Lans 2020
Miss 2646
7" @ 2647
T.D. 2650
Rust

9/1 "

9/8 "

9/15 T.D. 2657
Temp. Pot. 79 Pump

9/22 " " " "

OVER

1943

9/29

Miss 2646

7" @ 2647

Pump 250 Pot.

Gravity 36.3

T.D. 2657'

COMPLETED

Saline

KANSAS

Map No. 42 Sec. 20 Twp. 16 R. 1W

Well No. 2 Norton

Deep Rock Company

FIRST REPORT Contractor

NE SE NW

SECTION PLAT

 Ft. from N. Line

990 Ft. from S. Line

330 Ft. from E. Line

 Ft. from W. Line

		o	

HUNTER POOL

Location XXX

Rig up

Drilling and Remarks:

RECORD

Cased in., ft.

Sand

Gas

Oil

Total Depth

PRODUCTION

1st 24 hrs. Nat.

1st 24 hrs. after shot

Gas Cu. Ft.

Dry Hole

Abandoned

Date

AUG 4 1943 19

S. J. LEWIS Scout

KANSAS

Map No. 42 Sec. 20 Twp. 16 R. 1W

Well No. 2 Norton

Deep Rock

Company

COMPLETED

Contractor

NE SE NW

SECTION PLAT

_____ Ft. from N. Line

990 Ft. from S. Line

330 Ft. from E. Line

_____ Ft. from W. Line

	o		

Hunter Pool

Location ~~2~~

Rig up _____

Drilling and Remarks:

Miss 2646

7" @ 2647

Pump 250 Pst

36 2/3 G

RECORD

Cased _____ in., _____ ft.

Sand _____

Gas _____

Oil _____

Total Depth 2657

PRODUCTION

1st 24 hrs. Nat. _____

1st 24 hrs. after shot _____

Gas _____ Cu. Ft.

Dry Hole _____

Abandoned _____

Date

SEP 29 1943

19

S. J. LEWIS

Scout