


Section 8 Township 16 Range 3 W

Well No. # 3 Lindholm

Company Jones, Shelburne & Farmer

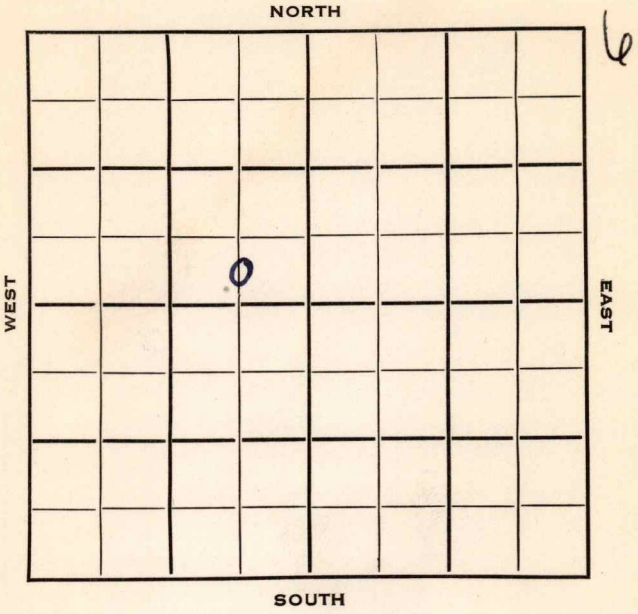

Saline

KANSAS

SEC.	TWP.	R.	
8-	16	3 W	✓


WELL NO. #.3 Lindholm FARM

COMPANY Jones, Shelburne & Farmer

CONTRACTOR Shields

Salemsborg Pool

_____ Ft. from N. Line
 330 _____ Ft. from S. Line
 660 _____ Ft. from E. Line
 _____ Ft. from W. Line

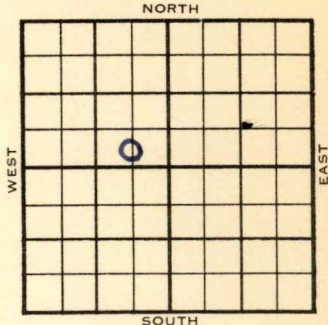

C S L SE NW

	ELEVATION	REPORT
1953	1335'	
11/24	MIR	
12/9	8" @ 357	Miss 2882 KH 3161 Mq Sha 3323' Drlg. 3325'
12/16	Mq Dol 3397'	RTD 3399' 5" @ 3397 CO 3399' SSO
1954		
1/20	Spud 11-24-53	Oil well TD 3399 82 8" @ 357 Anhy 340 Miss 2882 Kh. 3161 Maq. sh. 3323 Maq. dol. 3397 TD 3399 5" @ 3397 CO to 3399 SSO 500 A S/1 1/4 BOPH 4 hr. 1500 A S/5 BOPH 10 hr. Comp. 100 BOPD
		COMPLETED

County Saline State Kansas
 Sec. 8 (Blk.) 16 (Sur.) 3W Map No.
 Operator Jones, Shelburne & Farmer
 Well No. 3 Farm Lindholm
 Elev. 1335 Location C S L SE NW

COMPLETE									

330 Ft. From S Line NW
660 Ft. From E Line Quarter
 1st. Report
 Completion JAN 20 1954
 Remarks Salemsborg Pool
Shields - Contr.
 Spudding Date 11-24-53

Drilg. Data Oil well TD 3399
8" @ 357 Anhy 340 Miss. 2882
Kh. 3161 Maq. sh. 3323 Maq. dol. 3397
TD 3399 5" @ 3397 CO to 3399
SSO 500 A S/ 1 1/2 boph 4 hr. 1500 A
S/ 5 boph 10 hr. Comp. 100 bopd