


Section 31 Township 16 S Range 1 W

Well No. # 1 Van Meter

Company E. K. Carey Drlg. Co.

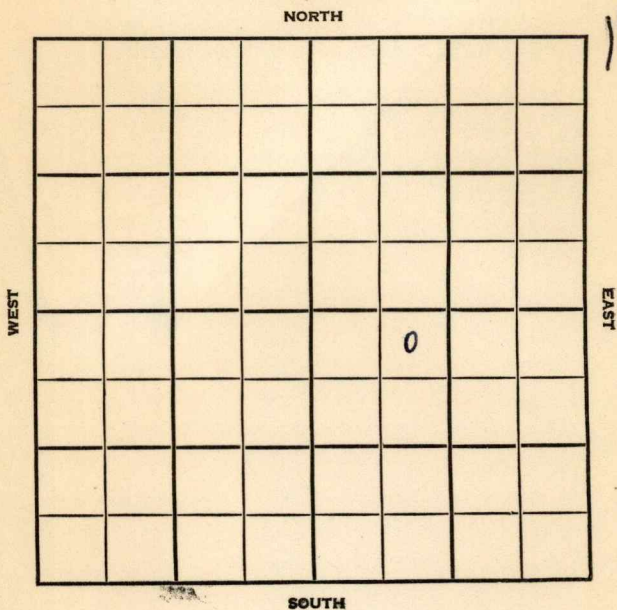

Saline

KANSAS


SEC.	TWP.	R.
31	16 S	1 W

WELL NO. # 1 Van Meter FARM

COMPANY E. K. Carey Drlg.

CONTRACTOR Co. tools Wildcat

360 Ft. from N. Line
 Ft. from S. Line
 Ft. from E. Line
 990 Ft. from W. Line

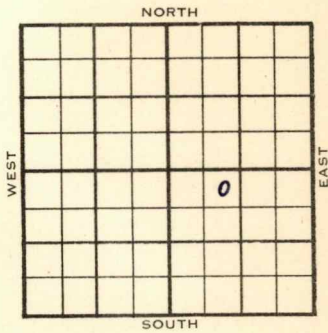

NE NW SE

	ELEVATION	REPORT
1954	1321'	

12/8 Spud 12-1-54
 8" @ 153
 Drlg. 1974'

12/15 Spud 12-1-54
 D & A
 TD 2710'
 8" @ 153'
 Heeb 1860' Doug 1880', Lans 2064'
 Cong 2638' Miss 2696'
 TD 2710'
 D & A

ABANDONED

