

Section 32 Township 16 Range 1WWell No. #3 AndersonCompany E. K. Carey

NORTH

SOUTH

WEST

EAST

8

0

Saline KANSAS ✓


Sec. 32 Twp. 16 R. 1WWell No. #3 Anderson FarmE. K. Carey CompanyCarey ContractorRoxbury Pool

Ft. from N. Line

990 Ft. from S. Line660 Ft. from E. Line

Ft. from W. Line

C N L SE NE

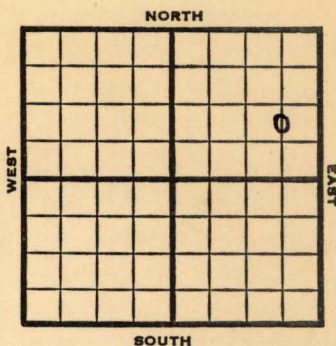

1953

Elev. 1291'

REPORT

7/29

Spud 7-23-53

8" @ 736

Drlg. 1678'

8/5

Lans 2028' Miss 2601' ~~TM~~

TD 2607' 5" @ 2602½

8/12

DD 2622 TD

S/1 BOPH 500A

S/6 BOPH 4 hrs., POP

8/19

NR

9/9

Spud 7-23-53

Oil Well

TD 2622

8" @ 736

Lans 2028, Miss 2601

TD 2607

5" @ 2602

DD 2622

S/1 boph 500A, S/6 boph 4 hrs.

Comp. 170 bopd 37% wtr.

COMPLETED

County

Saline

State

Kansas

Sec.

32

(Blk.)
(Twp.)

16

(Sur.)
(Rge.)

1W

Map No.

Operator

E. K. Carey

Well No.

3

Farm

Anderson

Elev.

Location

C N L S E N E

990 Ft. From

S Line

NE

660 Ft. From

E Line

Quarter

1st. Report

JUL 29 1953

Completion

Remarks

Carey - Contr.

Spudding Date


7-23-53

Drig. Data

Roxbury Pool

8" @ 736 drlg. 1678

drlg. 1678

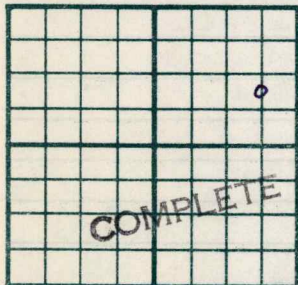County Saline State KansasSec. 32 (Blk. 16 (Sur. 1W Map No.)
(Twp.) (Rge.)Operator E. K. CareyWell No. 3 Farm AndersonElev. 1291 Location C N L SE NE990 Ft. From S Line NE660 Ft. From E Line Quarter1st. Report Completion SEP 9 1953Remarks Roxbury PoolCarey - Contr.Spudding Date 7-23-53Drilg. Data Oil well TD 26228" @ 736 Lans. 2028 Miss. 2601TD 2607 5" @ 2602 DD 2622S/ 1 boph 500 A S/ 6 boph 4 hr.Comp. 170 bopd 37% wtr.