


Section 2 Township 16 Range 4 W

Well No. # 2 Carlson-Sandberg

Company Franco Central & Penquin

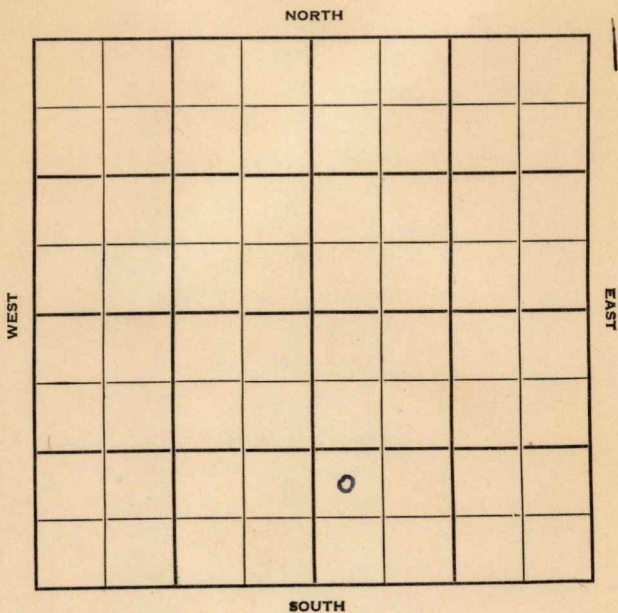

Saline

Sec. 2 Twp. 16 R. 4W

Well No. #2 Carlson-Sandberg Farm

Franco Central & Penguin Company

Penguin - Contr. Contractor  
Smolin


\_\_\_\_\_ Ft. from N. Line

990' Ft. from S. Line

\_\_\_\_\_ Ft. from E. Line

330' Ft. from W. Line

NW SW SE

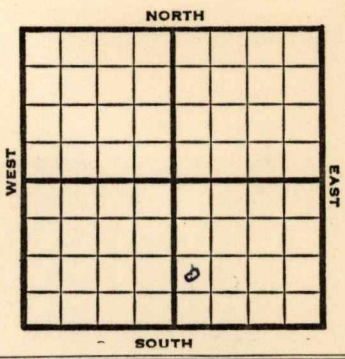

1952

**Elev. 1336'**

**REPORT**

5/21

Location

5/28

8" @ 315'

Drilg. 1575'

6/11

**Lans. 2304' Miss 2943' KH 3227'**  
**Mq shale 3381' Mq Dol 3446-48' RTD**  
**4" @ 3446'**

6/18

DP CO 3448 fill up 1600' oil  
6½ hrs.

6/25

NR

7/2

"

7/9

Spud 5-22-52

Oil well TD 3448' 8" @ 315'  
7" @ 596 **Lans. 2304' Miss 2943'**  
**Kh. 3227' Maq. sh. 3381' Maq. dol.**  
**3446' 4" @ 3446' TD 3448'**  
FU 1600' oil 6½ hr.  
Comp. 112 BOPD 5% water

**COMPLETED**



