

Summer


DX 78-1

KANSAS

Section 35 Township 34 Range 2E

Well No. #10 Higbee

Company Orville Parker.

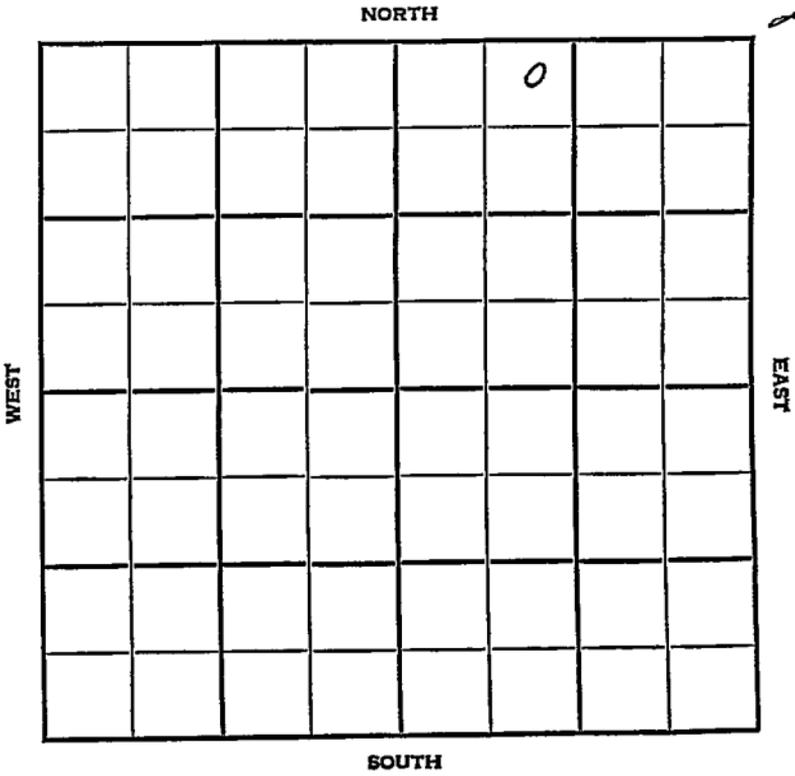

Sumner

KANSAS


SEC.	TWP.	R.
35	34	2 E

WELL NO. # 10 Higbee FARM

COMPANY Orville Parker

CONTRACTOR Smitherman Hilltop Pool

330 _____ Ft. from N. Line
 _____ Ft. from S. Line
 _____ Ft. from E. Line
 990 _____ Ft. from W. Line

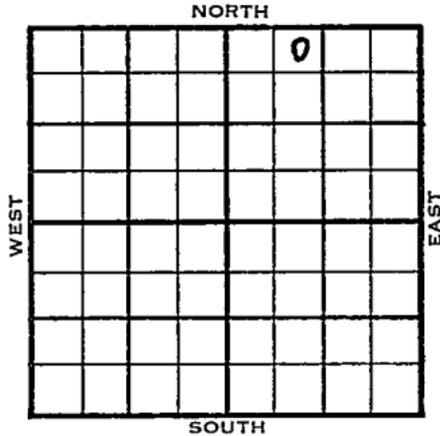

NE NW NE

ELEVATION	REPORT
-----------	--------

1955	-
3/2	Spud 2-15-55 8" @ 100 Drlg. 3400'
4/6	Spud 2-15-55 - Oil Well TD 3525' 8" @ 100' Layton 2809', KC 2976', Big Lime 3188' Bart. 3464', Miss chat 3500' TD 3525' 5" @ 3525' CO 24/3466-74, 12/3480-84, 34/3489-99, 24/3520-28, S/5 boph E/4 boph omp. 25 bopd

COMPLETED

County Sumner State Kansas

Sec. 35 (Blk. 34 (Sur. 2E (Twp. Rge.) Map No.

Operator Orville Parker

Well No. 10 Farm Higbee

Elev. _____ Location NE NW NE

330 Ft. From N Line NE

990 Ft. From W Line Quarter

Ist. Report MAR 2 1955

Completion _____

Remarks _____

Smitherman - Contr.

Spudding Date 2-15-55

Drlg. Data Hilltop Pool

8" @ 100 drlg. 3400

FABEN GILSTRAP

