


Section 35 Township 34 Range 2E

Well No. 13 Higbee

Company O. H. Parker

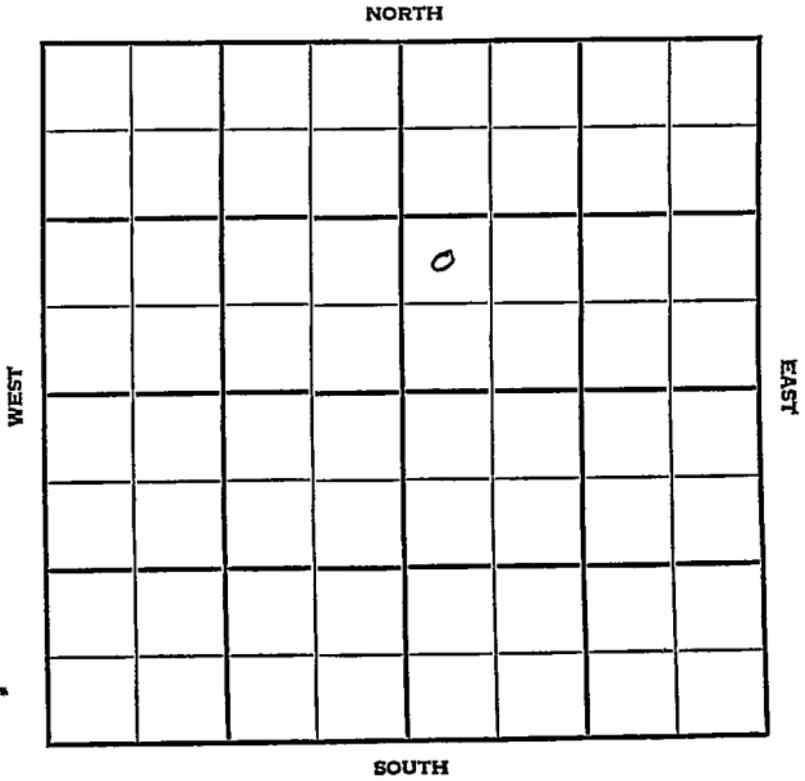

Sumner

KANSAS

SEC. 35	TWP. 34	R. 2E
------------	------------	----------


WELL NO. #13 Higbee FARM

COMPANY O.H. Parker

CONTRACTOR Smitherman

Hilltop Pool

_____ Ft. from N. Line
 990 _____ Ft. from S. Line
 _____ Ft. from E. Line
 330 _____ Ft. from W. Line

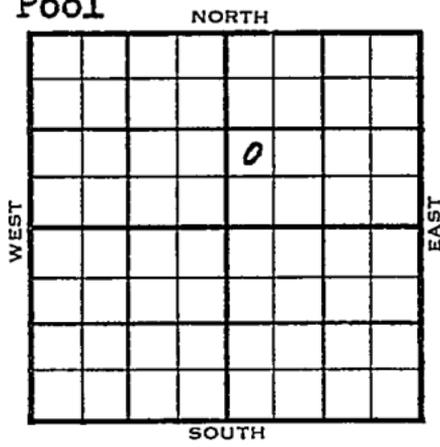

NW SW NE

	ELEVATION	REPORT
1955	1212'	
3/30	Spud 3-28-55 8" @ 120' WOC	
4/13	Spud 3-28-55 D & A TD 3512 8" @ 120 Layton 2811 KC 2982 Big line 3186 Bart 3474 Cong 3492 TD 3512' D & A	
	ABANDONED	


County Summer State Kansas

Sec. 35 (Blk. Twp.) 34 (Sur. Rge.) 2E Map No.

Operator O. H. Parker

Well No. 13 Farm Higbee

Elev. 1212 Location NW SW NE

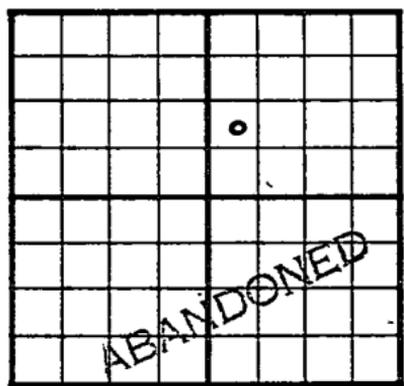

990 Ft. From S Line NE

330 Ft. From W Line Quarter

1st. Report

Completion APR 13 1955

Remarks Hilltop Pool

Smitherman - Contr.

Spudding Date 3-28-55

Drig. Data D & A TD3512

8" @ 120 Layton 2811 KC 2982

Big lime 3186 Bart. 3474 Cong. 3492

TD 3512

D & A