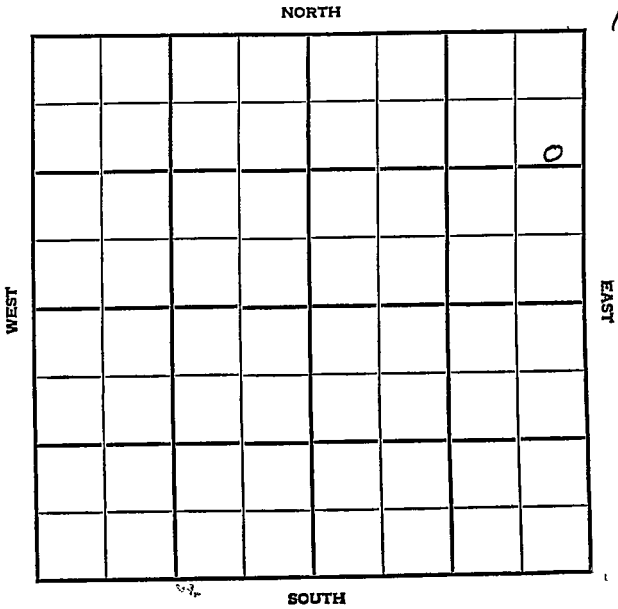


DX 78-1

Sumner

Section 35 34 Township 34 Range 2EWell No. # 11 Higby (Higbee)Company O. Parker

Sumner

KANSAS

SEC. 35	TWP. 34	R. 2E
------------	------------	----------

WELL NO.

#14 Higby

FARM

COMPANY

O. Parker

CONTRACTOR


_____ Ft. from N. Line

_____ Ft. from S. Line

_____ Ft. from E. Line

_____ Ft. from W. Line

SE NE NE

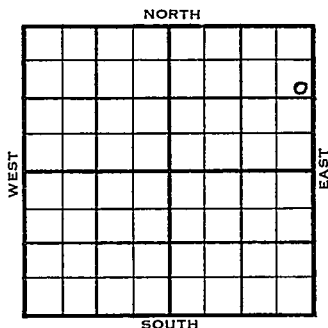

	ELEVATION	REPORT
1955	1233	

6/15

Comm 5-6-55
 8" @ 106-175 5" @ 3554/200
 CO to 3554 12/3551-54 24/3542-48
 32/3527-35 SP 3523, 32/3514-22
 16/3508-12 68/3478-95 250M-A
 frac Comp 35 bopd
 Tops: Depth Datum
 Layton 2808 1575
 KCBart 3479 2246
 BKCBart 3511 2278
 Miss 3532 2299
 TD. 3554

FIRST REPORT

+

COMPLETED

County Summer Elev. 1233
 Sec. 35 Twp. 34 Rge. 2E
 Company O. Parker
 Farm Name Higby No. 14

TOPS	DEPTH	LOG	DATUM	Loc. in Sec.
Anh.				SE NE NE
Tr.				
Dg.				
Bl.				
L. <u>ayton</u>	<u>2808</u>		<u>1575</u>	Geol.
K.C. <u>Bart</u>	<u>3479</u>		<u>2246</u>	Contr.
B.K.C. <u>Bartad</u>	<u>3511</u>		<u>2278</u>	
Ce.				
C.				
M. <u>iss</u>	<u>3532</u>		<u>2299</u>	Pool
M.				
K.				
Mz.				
Mq.				
V.				
S.				
S.				
A.				
R.				
P.				
G.				
T.D.	<u>3554</u>			

FIRST REPORT

COMPLETE

Date Comm. 5-6-55

JUN 15 1955

8" @ 106/175 5" @ 3554/200

CO to 3554 12/ 3551-54 24/ 3542-48

32/ 3527-35 SP 3523 32/ 3514-22

16/ 3508-12 68/ 3478-95 250 M-A

frac Comp. 35 bopd