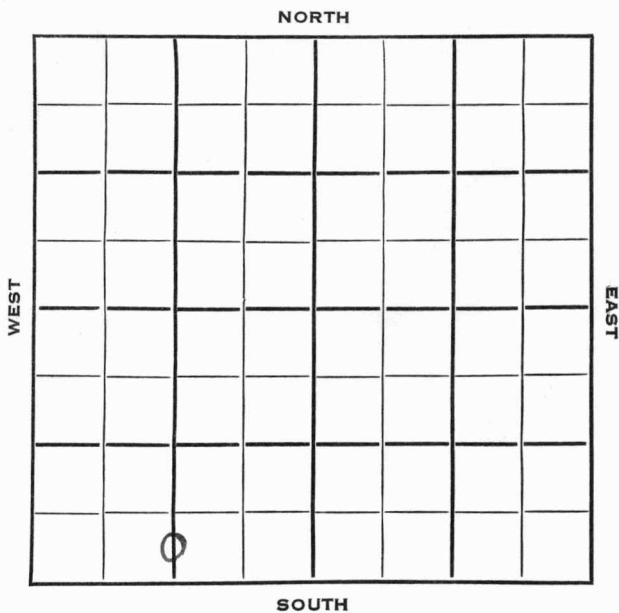


Section 32 Township 14 Range 13 WWell No. # 8 ErhlichCompany Skelly Oil

Russell

KANSAS ✓

Sec. 32 Twp. 14 R. 13WWell No. #8 Ehrlich FarmSkelly Oil


Company

Contractor

Ft. from N. Line

330 Ft. from S. Line

Ft. from E. Line

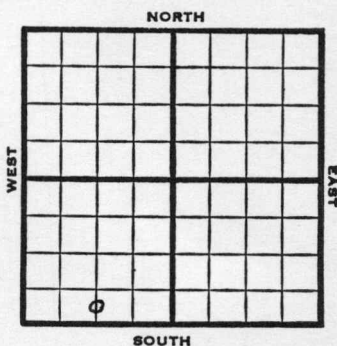1320 Ft. from W. LineC S $\frac{1}{2}$ S $\frac{1}{2}$ SW

1953

Elev. 1745'

REPORT

7/1
7/8

Location

Anhy 685,

10" @ 704'

Drlg 2260'

7/22

NR

8/26

Spud 6-29-53 Oil well TD 2998'

Anhy 685 10" @ 704 Indian cave

sd. 2277' Tarkio 2311 Heeb 2816

Tor. 2832 Doug 2848 Lans 2883

TD 2917 5" @ 2915 DD 2936

DD 2998 1 GO 7 GWPH 4 hr. 1000 A

P/1 BO 70 BW 7 hr. SP 2995

1000 A P/1 $\frac{1}{2}$ BO 6 $\frac{1}{2}$ BW 4 hrs.

PB 2850 63/2835-50 500 A dry

PB 2794 48/2789-91 25 GWPH 8 hr.

54/2767-76 5 GWPH 4 hr. PB 2328

49/2276-83 st-frac. P/22 BO 47 BWPD

P/2 BO 9 BW 4 hrs. CO to 2475

70/2454-64 sd-oil-frac.

S/1 BO 5 BW 3 hr. PB 2365 42/2312-18

2000 A P/18 BO 33 BW 16 hr.

Comp. 17 BOPD 40 BW

COMPLETED

County **Russell** State **Kansas**

Sec. **32** (Blk. **14**) (Sur. **13W**) Map No.

Operator Skelly Oil

Well No. 8 Farm Earlich

Elev.	Location	C	S $\frac{1}{2}$	S $\frac{1}{2}$	SW
-------	----------	---	-----------------	-----------------	----

0

330 Ft. From S Line SW

1320 Ft. From ☐ Line ☐ Quarter

1st. Report JUL 1 1953

Completion

Remarks

Spudding Date _____

Drlg. Data

Location

County Russell State Kansas

Sec. 32 (Blk. Twp.) 14 (Sur. Rge.) 13W Map No.

Operator Skelly Oil

Well No. 8 Farm Ehrlich

Elev. 1745 Location C S $\frac{1}{2}$ S $\frac{1}{2}$ SW

330Ft. From S Line SW

1320 Ft. From W Line Quarter

1st. Report

Completion AUG 26 1953

Remarks

Spudding Date 6-29-53

Drig. Data Oil well TD 2998

Anhy 685 10" @ 704 Indian cave sd.

2277 Tarkio 2311 Heeb. 2816 Tor. 2832

Doug. 2848 Lans. 2883 TD 2917

5" @ 2915 DD 2936 DD 2998 1 go 7 gwph

4 hr. 1000 A P/ 1 bo 70 bw 7 hr.

SP 2995 1000 A P/ $1\frac{1}{2}$ bo $6\frac{1}{2}$ bw 4 hr.

PB 2850 63/ 2835-50 500 A dry

PB 2794 48/ 2789-91 25 gwph 8 hr.

54/ 2767-76 5 gwph 4 hr. PB 2328

49/ 2276-83 st-frac P/ 22 bo 47 bwpd

P/ 2 bo 9 bw 4 hr. CO to 2476

70/ 2454-64 sd-oil-frac S/ 1 bo 5 bw

3 hr. PB 2365 42/ 2312-18 2000 A

p/ 18 bo 33 bw 16 hr.

Comp. 17 bopd 40 bw J. G. McGEHEE