

Section 32 Township 14 Range 13WWell No. #5
#2 RoggCompany Trapp Bros.

NORTH

							0

WEST

EAST

SOUTH

Russell

KANSAS

Sec. 32 Twp. 14 R. 13 W

Well No. # 2 Rogg Farm

Trapp Bros. Company

Contractor

Hall Gurney

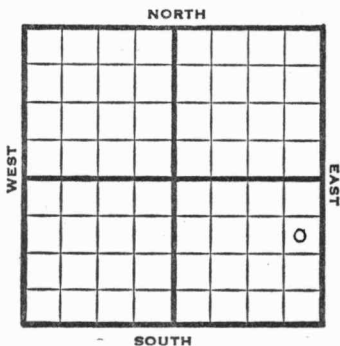
990 Ft. from N. Line

 Ft. from S. Line

330 Ft. from E. Line

 Ft. from W. Line

SE NE SE



1951

Elev. 1700'

REPORT

11/14

RUR

1952

1/2

Spud 11-13-51

Oil Well TD 2259

15" @ 61

Anhy 644

8" @ 2170

Tar. 2235

7" @ 2235

TD 2259

PB 2238

HF Comp. 25 BOPD

COMPLETED

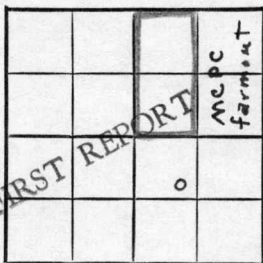
Kansas

Hall-Gurney Pool

Map No. _____ Sec. 32 Twp. 14 R. 13WWell No. 2 Rogg_____C. Trapp_____
Company_____
Contractor

SE NW SE

SECTION PLAT

990 Ft. from N. Line_____
Ft. from S. Line_____
Ft. from E. Line990 Ft. from W. Line

Russell County

Location X

Rig up _____

Drilling and Remarks:

RECORD

Cased _____ in., _____ ft.

Sand _____

Gas _____

Oil _____

Total Depth _____

PRODUCTION

1st 24 hrs. Nat. _____

1st 24 hrs. after shot _____

Gas _____ Cu. Ft.

Dry Hole _____

Abandoned _____

Date

JUL 12 1950 19J. E. TYRA Scout

J. E. TYRA

KANSAS

Map No. _____ Sec. 32 Twp. 14 R. 13WWell No. 5 Rogg_____ Trapp Bros. _____ Company

CORRECTION

_____ Contractor

SE NE SE

SECTION PLAT

_____ 990 Ft. from N. Line

_____ Ft. from S. Line

_____ 330 Ft. from E. Line

_____ Ft. from W. Line

			o

Russell County

Location _____

Rig up _____

Drilling and Remarks:

Reported

#2 Rogg

RECORD

Cased _____ in., _____ ft.

Sand _____

Gas _____

Oil _____

Total Depth _____

PRODUCTION

1st 24 hrs. Nat. _____

1st 24 hrs. after shot _____

Gas _____ Cu. Ft.

Dry Hole _____

Abandoned _____

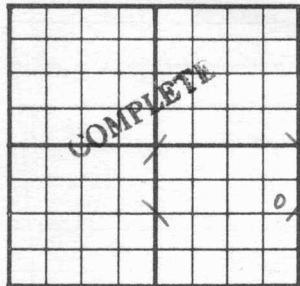
Date

DEC 5 1951

19

J. E. TYRA

Scout

County Russell State KansasSec. 32 (Blk.
Twps.) 14 (Sur.
Rge.) 13W Map No.Operator Trapp Bros.Well No. 5 Farm RoggElev. 1700 Location SE NE SE990 Ft. From N Line SE330 Ft. From E Line Quarter

1st. Report _____

Completion JAN 2 1952Remarks Hall-Gurney PoolSpudding Date 11-13-51Drlg. Data Oil well TD 225915" @ 61 Anhy 644 8" @ 2170Tarkio 2235 7" @ 2235 TD 2259 PB 2238Hydrofrac Comp. 25 bopd

J. E. TYRA