
FORM 51 25M 8-50 WESTERN Saline KANSAS

Section 33 Township 16 Range 1 W

Well No. # 1 Stein

Company E. K. Carey

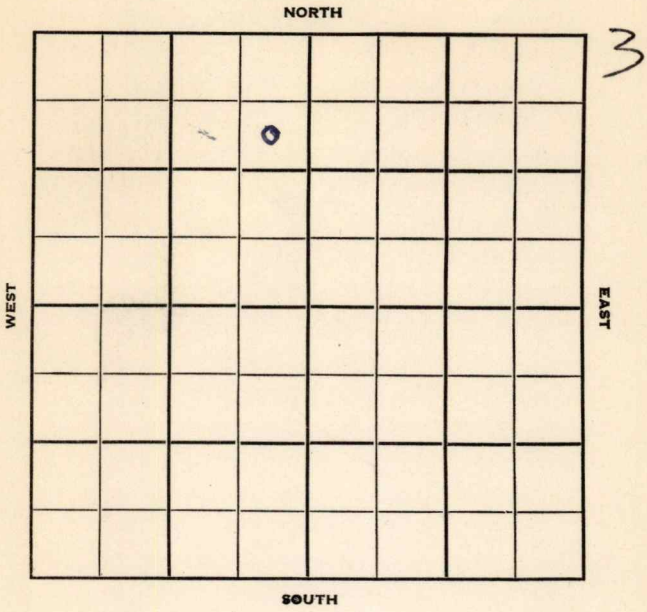

FORM 252-B
10M 8-51 TPCO.

Saline

KANSAS ✓

Sec. 33 Twp. 16 R. 1W

Well No. #1 Stein Farm

E. K. Carey Company

Carey - Contr. Contractor

Semi-Wildcat


990' Ft. from N. Line

Ft. from S. Line

330' Ft. from E. Line

Ft. from W. Line

SE NE NW

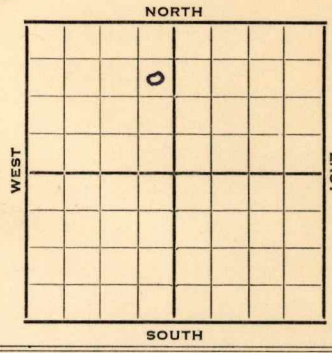

1952	Elev. 1275' REPORT
6/4	Spud 5-28-52 Anhy 105 8" @ 126 KC 2005 Drlg. 2440
6/11	Miss li 2594-2600' RTD 4" @ 2597 DP CO 2600' Fill up 300' oil 12 hrs. DD 2614' S/1½ BOPH To A
6/18	1000 A S/17 BOPH POP
6/25	NR
7/2	"
7/9	"
7/17	"
7/23	Spud date 5-28-52 Oil Well TD 2614 Anhy 105 8" @ 126 KC 2005 Miss 2594 4" @ 2597 TD 2600 FU 300' oil 12 hr. DD 2614 S/1½ boph 1000 A S/17 boph Comp. 303 bopd 40% wtr.

FORM 275 FOR SALE BY KANSAS BLUE PRINT CO.


County Saline State Kansas

Sec. 33 (Blk. Twp.) 16 (Sur. Rge.) 1W Map No.

Operator E. K. Carey

Well No. 1 Farm Stein

Elev. 1275 Location SE NE NW

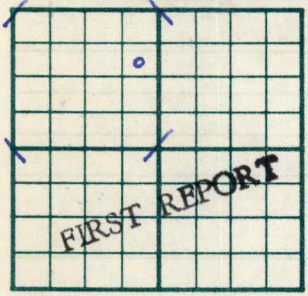

990 Ft. From N Line NW

330 Ft. From E Line Quarter

1st. Report JUN 4 1952

Completion

Remarks Texas Fairmont ~~$2500 DHM~~

Carey - Contr.

Spudding Date 5-28-52

Drlg. Data Semi Wildcat

Amhy 105 8" @ 126 KC 2005 drlg. 2440

J. G. McGEHEE

FORM 275 FOR SALE BY KANSAS BLUE PRINT CO.


County Saline State Kansas

Sec. 33 (Blk. Twp.) 16 (Sur. Rge.) 1W Map No.

Operator E. K. Carey

Well No. 1 Farm Stein

Elev. 1275 Location SE NE NW

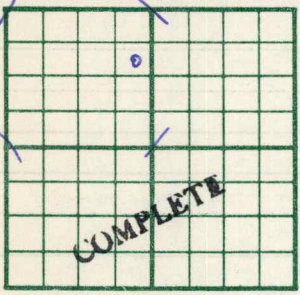

990 Ft. From N Line NW

330 Ft. From E Line Quarter

1st. Report

Completion JUL 2 3 1952

Remarks Semi Wildcat

Carey - Contr.

Spudding Date 5-28-52

Drlg. Data Oil well TD 2614

Anhy 105 8" @ 126 KC 2005

Miss. 2594 4" @ 2597 TD 2600

FU 300' oil 12 hr. DD 2614 S/ 1½ boph

1000 A S/ 17 boph

Comp. 303 bopd 40% water

J. G. McGEHEE