KANSAS

Russell


FORM 51 5M 4-41 PETROL

Section 32 Township 14 Range 13-W

Well No. #1 Resley

Company Colorado Petroleum

NORTH Hall Gurney Pool

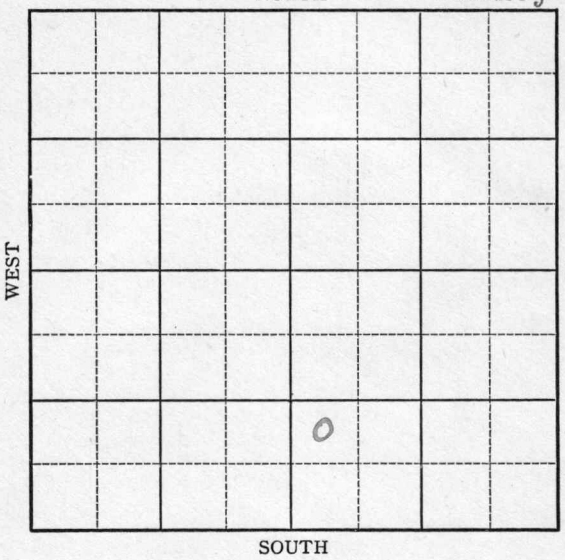

FORM 252-A
5M 10-41 PETROL

KANSAS Russell

Sec. 32 Twp. 14 R. 13-W

Well No. #1 Resley Farm

Colorado Petr. Company

(Hall - Gurney)


____ Ft. from N. Line

990 Ft. from S. Line

____ Ft. from E. Line

330 Ft. from W. Line

Elev. 1731

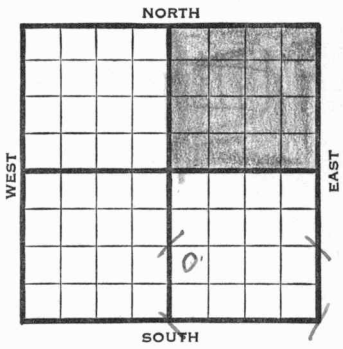

1942	REPORT
6/10	Location
6/17	Lans. 2865' S.O. 2886-96 - 2901-14'
	T.D. 3156' 5" - 2948' RUST.
6/24	" " " "
7/1	Arb. 3154' 53 shots 2881-2910'
	Swab 10 oil per hour. Will acidize.
7/8	Lans. 2865'
	5" - 2948'
	T.D. 3156'
	10,000 acid.
	Potential 756 bbls., pump.
	39. Gravity
	COMPLETED

Form 26 200 Bks. 5-41 McW.

KANSAS

Russell

Map No. 72 Sec. 32 Twp. 14 R. 13W


Well No. 1 Resley

Colorado Petroleum Company

FIRST REPORT Contractor

NW SW SE

SECTION PLAT

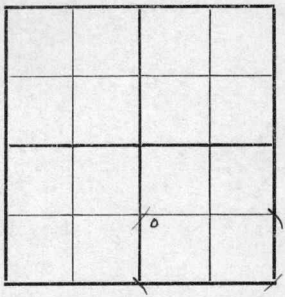

____ Ft. from N. Line

990 Ft. from S. Line

____ Ft. from E. Line

330 Ft. from W. Line

HALL GURNEY POOL

Location XXX

Rig up

Drilling and Remarks:

RECORD

Cased ____ in., ____ ft.

Sand

Gas

Oil

Total Depth

PRODUCTION

1st 24 hrs. Nat.

1st 24 hrs. after shot

Gas ____ Cu. Ft.

Dry Hole

Abandoned

Date

JUN 10 1942 19

S. J. LEWIS Scout

Form 26 200 Bks. 5-41 McW.

Russell KANSAS

Map No. 72 Sec. 32 Twp. 14 R. 13W

Well No. 1 Resley

Colorado Petroleum Company

COMPLETED Contractor

NW SW SE


Ft. from N. Line

990 Ft. from S. Line

Ft. from E. Line

330 Ft. from W. Line

SECTION PLAT

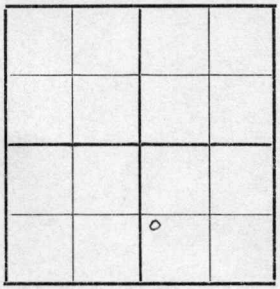

HALL-GURNEY POOL

Location

Rig up

Drilling and Remarks:

Lane 2865-
5" @ 2948
10000 Acid
Pump 75-6 B.P.

39°-4

RECORD

Cased in., ft.

Sand

Gas

Oil

Total Depth 3156

PRODUCTION

1st 24 hrs. Nat.

1st 24 hrs. after shot

Gas Cu. Ft.

Dry Hole

Abandoned

Date

JUL 8 1942 19

S. J. LEWIS Scout