


Section 33 Township 16 Range 1 W

Well No. # 1 Stein "A"

Company E. K. Carey

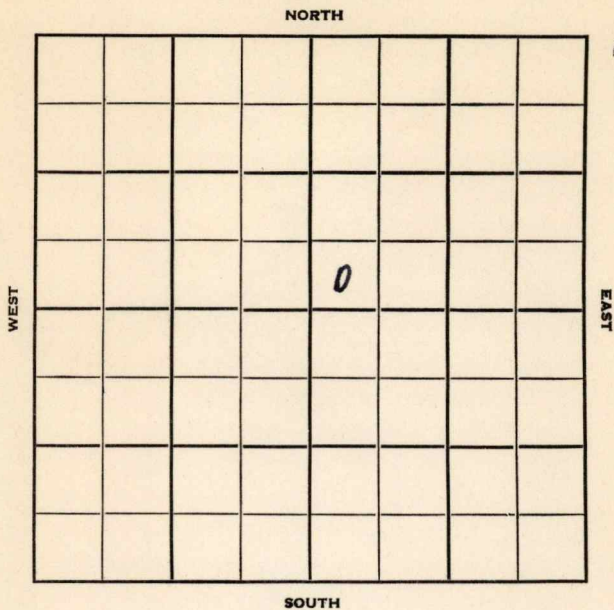

Sec. 33 Twp. 16 R. 1 W

Well No. # 1 Stein "A" Farm

E. K. Carey Company

Carey Drlg. Contractor


Gypsum Creek Pool NORTH

Ft. from N. Line

330 Ft. from S. Line

Ft. from E. Line

330 Ft. from W. Line

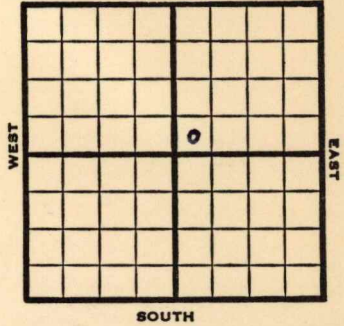

SW SW NE
Texas Farmout

1953 **Elev. 1279'** REPORT

6/17 Spud 6-12-53
8" @ 117
Drlg. 1590'

6/24 **Doug 1829' KC 2005 Miss 2614**
DST 2617-22, 55' M & W
Drlg. 2900 for SWD

7/1 **Htn 2974, Mq 3070, V 3170, Simp 3250,**
Arb. 3328
RTD 3669
5" @ 3245

7/8 CO

7/22 Spud 6-12-53
SWD Well
TD 3669
8" @ 117
Doug 1829, KC 2005, Miss 2614
DST 2617-22, opn 1 1/4 hrs., rec. 55' mud
& wtr.,
Hunton 2974, Maq. 3070, Viola 3170,
Simp. 3250, Arb. 3328
TD 3669'
5" @ 3345
CO to 3669
Comp. for SWD Well

ABANDONED

County **Saline** State **Kansas**

Sec. **33** (Blk.) **16** (Sur. Rge.) **1W** Map No.

Operator **E. K. Carey**

Well No. **1** Farm **Stein "A"**

Elev. Location **SW SW NE**



330 Ft. From **S** Line **NE**

330 Ft. From **W** Line **Quarter**

1st. Report **JUN 17 1953**

Completion

Remarks **Texas farmout**

Carey Drlg. - Contr.

Spudding Date **6-12-53**

Drlg. Data **Gypsum Creek Pool**

8" @ 117 drlg. 1590

County Saline State Kansas

Sec. 33 (Blk. Twp.) 16 (Sur. Rge.) 1W Map No.

Operator E. K. Carey

Well No. 1 Farm Stein "A"

Elev. 1279 Location SW SW NE



330 Ft. From S Line NE

330 Ft. From W Line Quarter

1st. Report

Completion JUL 22 1953

Remarks Gypsum Creek Pool

Carey Drlg. - Contr.

Spudding Date 6-12-53

Drlg. Data SWD well TD 3669

8" @ 117 Doug. 1829 KC 2005

Miss. 2614 DST 2617-22 open 1 1/4 hr.

Rec. 55' mud & wtr. Hunton 2974

Mag. 3070 Viola 3170 Simp. 3250

Arb. 3328 TD 3669 5" @ 3345

CO to 3669 Comp. for SWD well