

Saline


KANSAS

DX 78-1

Section 33 Township 16 Range 1W

Well No. #1 Stein "A"

Company F.S. Williams

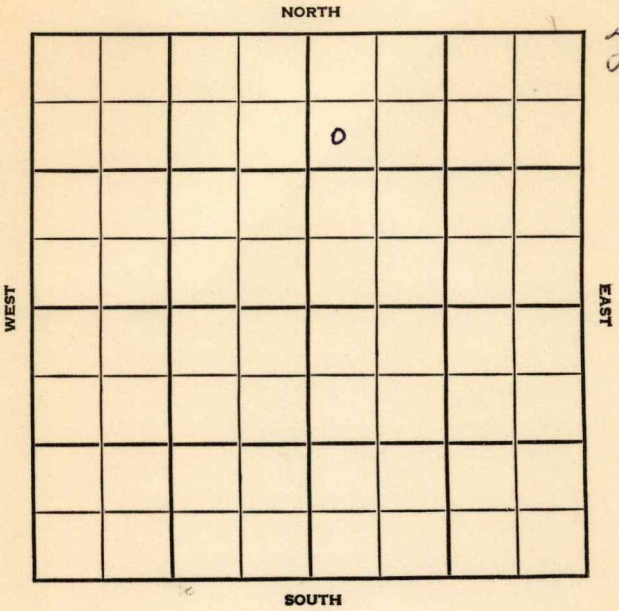

SEC.	TWP.	R.
33	16	1W

WELL NO.

#1 Stein "A"

FARM

COMPANY

F. S. Williams

CONTRACTOR

Stearns

Gypsum Creek Pool

990


Ft. from N. Line

Ft. from S. Line

Ft. from E. Line

330

Ft. from W. Line

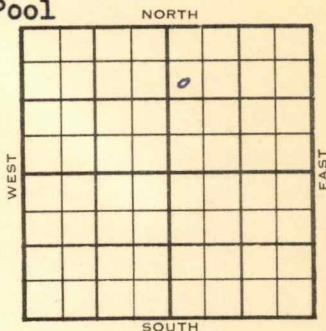

SW NW NE

	ELEVATION	REPORT
1954	1277'	

11/23 Spud 11-18-54

8" @ 126'

Drlg. 1605'

12/22 Spud 11-18-54

Oil Well

TD 2622'

8" @ 126'

Miss 2602'

TD 2612'

5" @ 2611'

KC 1994'

DD 2622' FU 350' fluid 16 hr. (300' oil, 50% Wtr.) 500 A

B/ 3 bfph 10% Wtr. 4 hr

Comp 40 bopd. 70 bw.

COMPLETED

