


Section 33 Township 16 Range 1W

Well No. #1 Stein "A"

Company F. S. Williams

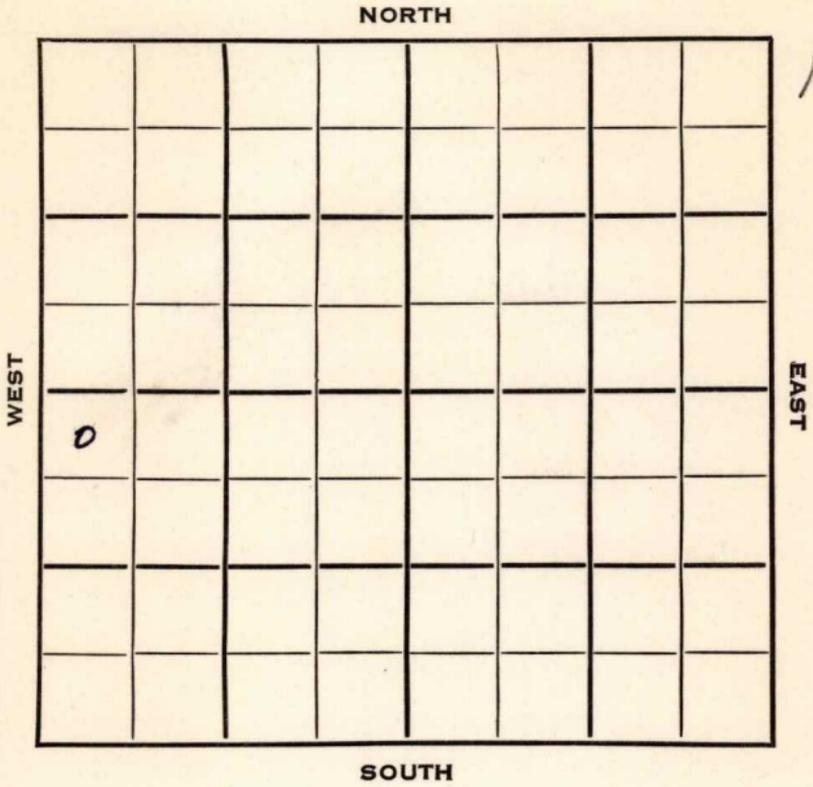



Sec. 33 Twp. 16 R. 1 W

Well No. # 1 Stein "A" Farm

F. S. Williams Company

Mallard Drlg. Contractor


330 Ft. from N. Line

Ft. from S. Line

Ft. from E. Line

330 Ft. from W. Line

NW NW SW

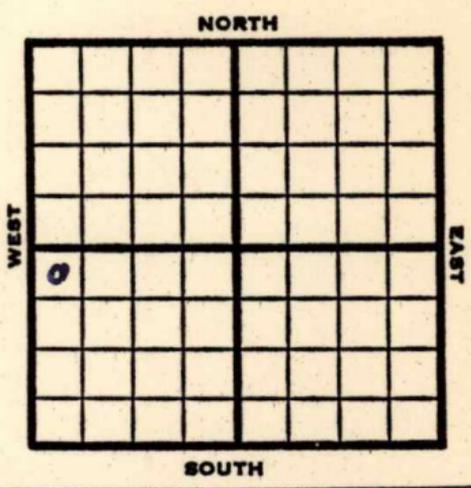

1953 Elev. 1276' REPORT

2/4 Location

2/12 "

2/19 8" @ 135 Miss 2594-27'
RTD 5" @ 2597

2/26 DD 2607 TD 250A
S/33 BO + 27 BW 7 1/2 hrs.

3/12 NR

3/19 NR

3/26 NR

4/2 "

4/9 "

4/16 NR

4/23 "

4/29 Spud 2-9-53
Oil Well
TD 2607
8" @ 135,
KC 1992, Miss 2594
TD 2597
5" @ 2597
DD 2607, 250A, S/33 bo 27 bw 1 1/2 hrs.
25 boph 50% wtr.
Comp. 75 bopd 50% wtr.

COMPLETED

County Saline State Kansas

Sec. 33 (Blk. 16 (Sur. 1W (Twp. Map No. Rge.)

Operator F. S. Williams

Well No. 1 Farm Stein "A"

Elev. 1276 Location NW NW SW

0	COMPLETE				

330 Ft. From N Line SW

330 Ft. From W Line Quarter

1st. Report

Completion APR 29 1953

Remarks

Mallard Drlg. - Contr.

Spudding Date 2-9-53

Drlg. Data Oil well TD 2607

8" @ 135 MC 1992 Miss. 2594 TD 2597

5" @ 2597 DD 2607 250 A S/ 33 bo

27 bw 1 1/2 hr. 25 bopd 50% wtr.

Comp. 75 bopd 50% wtr.