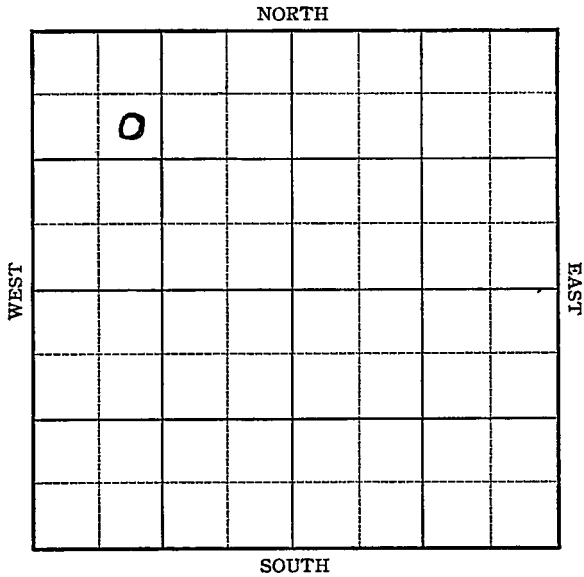


Barton

Section 34 Township 16 Range 13-WWell No. 7 - RiemannCompany Stanolind

Barton KANSASMap No. _____ Sec. *34* Twp. *16* R. *13^w*Well No. *7 - Riemann**Stanolind* Company

Contractor

FIRST REPORT

SECTION PLAT

990 Ft. from N. Line

_____ Ft. from S. Line

_____ Ft. from E. Line

990 Ft. from W. Line

0			
			1

Location _____

Rig up _____

Drilling and Remarks:

R. U. R.

RECORD

Cased _____ in., _____ ft.

Sand _____

Gas _____

Oil _____

Total Depth _____

PRODUCTION

1st 24 hrs. Nat. _____

1st 24 hrs. after shot _____

Gas _____ Cu. Ft.

Dry Hole _____

Abandoned _____

Date

SEP 15 1937

19

H. D. Hatfield Scout

Barton

KANSAS

Map No. _____ Sec. 34 Twp. 16 R. 13WWell No. 7 RiemanStanolind Company._____
Contractor

COMPLETED

SE NW NW

990 Ft. from N. Line

____ Ft. from S. Line

____ Ft. from E. Line

990 Ft. from W. Line

SECTION PLAT

0			

Location _____

Rig up _____

Drilling and Remarks:

2000 AcidPOT 1620

RECORD

Cased 6 in., 3394 ft.Sand 511 3394

Gas _____

Oil _____

Total Depth 3400

PRODUCTION

1st 24 hrs. Nat. _____

1st 24 hrs. after shot _____

Gas _____ Cu. Ft.

Dry Hole _____

Abandoned _____

Date

OCT 20 1937 19 H. D. Hatfield Scout