


Section 33 Township 16 Range 1W

Well No. #3 Stein

Company E. K. Carey

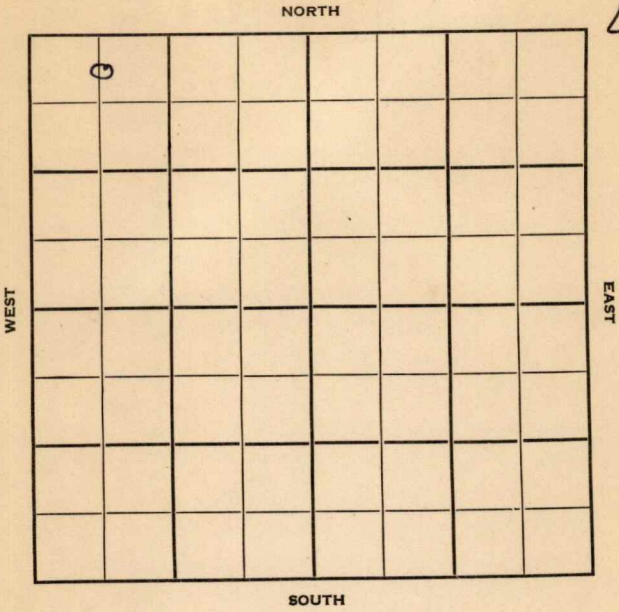

Saline

Sec. 33 Twp. 16 R. 1W

Well No. #3 Stein Farm

E. K. Carey Company

Carey Drlg. Contractor


330 Ft. from N. Line

Ft. from S. Line

Ft. from E. Line

660 Ft. from W. Line

NW 1/4 C N L NW NW

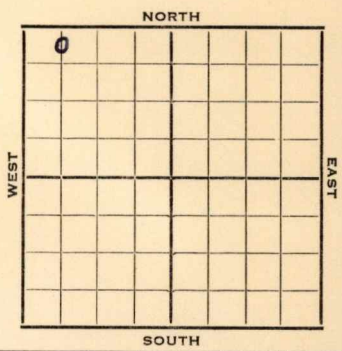

1952 Elev. 1275' REPORT

- 10/29 Location
- 11/5 8" @ 116'
Drlg. 713'
- 11/12 K. 1990 Miss. 2592 -95
RTD 3" @ 2593'
- 11/20 NR
- 11/27 POP
- 12/4 NR
- 12/11 NR
- 12/18 NR
- 12/25 NR
- 12/30 Spud 10-31-52
Oil Well
TD 2603
8" @ 116
KC 1990, Miss 2592
5" @ 2593
TD 2603
500A S/16 boph
Comp. 252 bopd 5% wtr.

COMPLETED

County Saline State Kansas

Sec. 33 (Blk. 16 (Sur. 1W (Twp.) (Rge.) Map No.

Operator E. K. Carey

Well No. 3 Farm Stein

Elev. _____ Location C N L NW NW

0					

330Ft. From N Line NW

660Ft. From W Line Quarter

OCT 29 1952

1st. Report _____

Completion _____

Remarks _____

Carey Drlg. - Contr.

Spudding Date _____

Drlg. Data _____

Location

County Saline State Kansas
 Sec. 33 (Blk. 16 (Sur. 1W Map No.)
 Operator E. K. Carey
 Well No. 3 Farm Stein
 Elev. 1275 Location C N L NW NW

0					

330 Ft. From N Line NW
660 Ft. From W Line Quarter
 1st. Report
 Completion DEC 30 1952
 Remarks
Carey Drlg. - Contr.
 Spudding Date 10-31-52

Drlg. Data Oil well TD 2603
8" @ 116 KC 1990 Miss. 2592
5" @ 2593 TD 2603 500 A S/ 16 boph
Comp. 252 bopd 5% wtr.

2000
 Land Small Map
 Land Wall Map
 Price Map
 Misc.