

KANSAS


Form 51—5M—7-39—Palace

Russell

Section 32 Township 14 Range 13-W

Well No. #12 Opdycke

Company Skelly

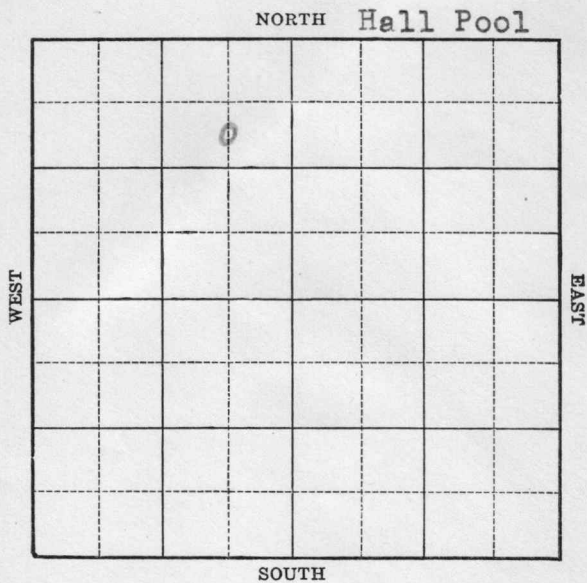

Sec. 32 Twp. 14 R. 13-WWell No. #12 Opdycke FarmSkelly

Company

(Hall)

990 ¹⁰⁴⁸

Ft. from N. Line


Ft. from S. Line

⁷¹⁶660

Ft. from E. Line

Ft. from W. Line

Elev. 1708

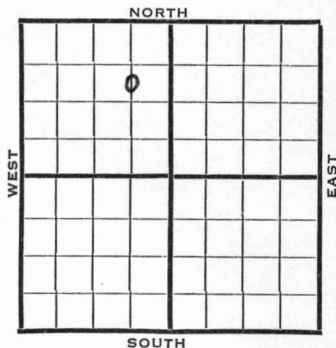

1940	REPORT
6/26	Location
7/3	"
7/11	"
7/18	Derrick.
7/25	10" - 281' Drlg. 1452'
8/2	Lansing ²⁸⁵⁰ 2855 Pay 2855-57'
	Run 6".
8/8	Lans. 2850' (Corrected)
	6" - 2852' T.D. 2976'
	900' oil 24 hours.
8/14	Lans. 2850'
	6" - 2852'
	T.D. 2977½'
	Potential 1402 bbls., pump.
	COMPLETED

Map No. 72 Sec. 32 Twp. 14 R. 13WWell No. 12 OpdyckeSkelly CompanyFIRST REPORT Contractor

C S L NE NW

SECTION PLAT

990 Ft. from N. Line Ft. from S. Line660 Ft. from E. Line Ft. from W. Line

HALL POOL

Location XRig up

Drilling and Remarks:

RECORD

Cased in., ft.Sand Gas Oil Total Depth

PRODUCTION

1st 24 hrs. Nat. 1st 24 hrs. after shot Gas Cu. Ft.Dry Hole Abandoned

Date

JUN 26 1940 19S. J. LEWIS Scout

Map No. _____ Sec. 32 Twp. 14 R. 13WWell No. 12 OpdyckeSkelly Oil Company

CORRECTION Contractor

C S L NE NW

SECTION PLAT

	o		

1048 Ft. from N. Line

_____ Ft. from S. Line

716 Ft. from E. Line

_____ Ft. from W. Line

HALL POOL

Location _____

RECORD

Cased _____ in., _____ ft.

Sand _____

Gas _____

Oil _____

Total Depth _____

Rig up _____

Drilling and Remarks:

Reported

990 x 716

PRODUCTION

1st 24 hrs. Nat. _____

1st 24 hrs. after shot _____

Gas _____ Cu. Ft.

Dry Hole _____

Abandoned _____

Date

JUL 18 1940 19

S. J. LEWIS Scout

Map No. _____ Sec. 32 Twp. 14 R. 13WWell No. 12 OpdyckeSkelly Oil

Company _____

Contractor _____

COMPLETED**SECTION PLAT**1048 C S L NE NW
Ft. from N. Line

____ Ft. from S. Line

716 Ft. from E. Line

____ Ft. from W. Line

HALL POOL

	o		

Location _____

Rig up _____

Drilling and Remarks:

*L. cas 2850**6" @ 2852.**Pump 1402 Bx.***RECORD**

Cased _____ in., _____ ft.

Sand _____

Gas _____

Oil _____

Total Depth 2977 1/2**PRODUCTION**

1st 24 hrs. Nat. _____

1st 24 hrs. after shot _____

Gas _____ Cu. Ft.

Dry Hole _____

Abandoned _____

Date

AUG 14 1940 19S. J. LEWIS

Scout