

KANSAS


Barton

FORM 51 5M 10-41 PETROL

Section 34 Township 16 Range 15-W

Well No. #10 Riemann

Company Stanolind

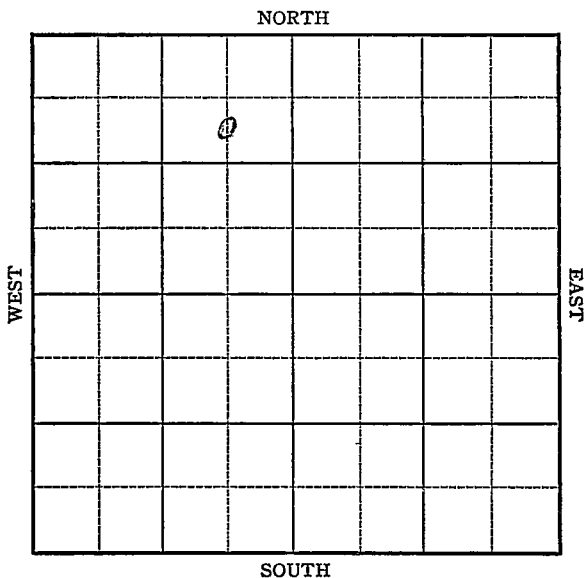


Sec. 34 Twp. 16 R. 13-W

Well No. #10 Riemann Farm
Stanolind Company

(Trapp)

990 Ft. from N. Line
 Ft. from S. Line
66.0 Ft. from E. Line
 Ft. from W. Line

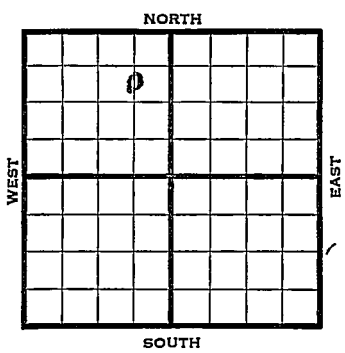

Elw. 1952

1941	REPORT
11/12	Derrick.
11/20	8" - 257' Anhy. 873'
	Drlg. 2125'
11/26	Lans. 3180' Arb. 3414-18' T.D.
	Run csg.
12/4	5" - 3412' T.D. 3421'
	3000 acid.
12/11	Pump 12 Fluid PH 6 hrs.
	50% water SD.
12/17	Arb. 3414
	5" @ 3412
	300 acid
	Pump 250 oil & 46% water
	TD 3421
	Grav. 40.5
	COMPLETED

Barton

KANSAS

Map No. 173 Sec. 34 Twp. 16 R. 13W

Well No. 10 Riemann

Stanolind Company

FIRST REPORT

Contractor

C SL NE NW

990 Ft. from N. Line

_____ Ft. from S. Line

660 Ft. from E. Line

_____ Ft. from W. Line

SECTION PLAT

	o		

TRAPP POOL

Location _____

Rig up _____

Drilling and Remarks:

Derrick

RECORD

Cased _____ in., _____ ft.

Sand _____

Gas _____

Oil _____

Total Depth _____

PRODUCTION

1st 24 hrs. Nat. _____

1st 24 hrs. after shot _____

Gas _____ Cu. Ft.

Dry Hole _____

Abandoned _____

Date

NOV 12 1941 19

S. J. LEWIS

Scout

Map No. 23 Sec. 34 Twp. 16 R. 13W

Well No. 10 Riemann

Stanolind Company

COMPLETED Contractor

C SL NE NW

990 Ft. from N. Line

 Ft. from S. Line

660 Ft. from E. Line

 Ft. from W. Line

SECTION PLAT

	o		

TRAPP POOL

Location _____

Rig up _____

Drilling and Remarks:

Cor 83414
5' to 34R
300cc oil
Pump 250 oil
+ 46% water
405/yr

RECORD

Cased _____ in., _____ ft.

Sand _____

Gas _____

Oil _____

Total Depth 342'

PRODUCTION

1st 24 hrs. Nat. _____

1st 24 hrs. after shot _____

Gas _____ Cu. Ft.

Dry Hole _____

Abandoned _____

Date

DEC 17 1941 19

S. J. LEWIS Scout