


Russell

KANSAS

Section 32 Township 14 Range 13-W

Well No. 4 Opdycke

Company Skelly

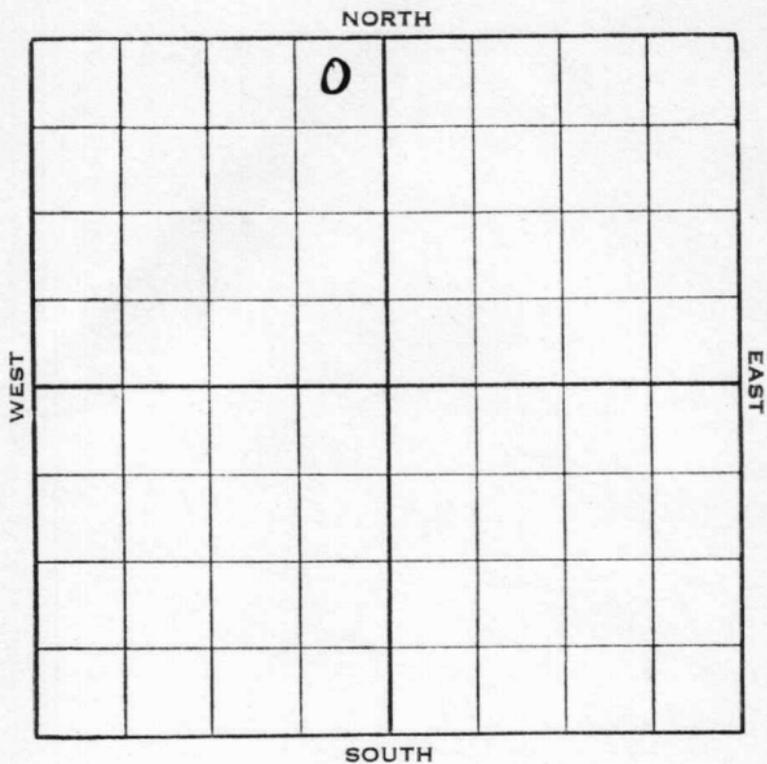

KANSAS

Russell

Sec. 32 Twp. 14 R. 13-W


Well No. #4 Opdycke Farm
Skelly Company

330 Ft. from N. Line

_____ Ft. from S. Line

330 Ft. from E. Line

_____ Ft. from W. Line

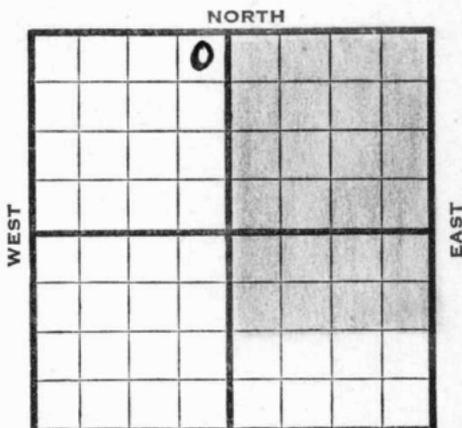

offset our #1 Rogg completed well

Elev. 1733'.

REPORT

1938	
9/14	Moving in tools.
9/16	Bldg. rotary rig (Tel)
9/19	Rigging up rotary. (Letter from H.D.H.)
9/23	13" - 297'. WOC.
9/24	13" 299 WOC (Tel)
9/26	Dlg. 1275 (Tel)
9/30	Drlg. 1520'.
9/30	Dlg. 2020 (Tel)
10/7	Drlg. 2575'.
10/8	Top Lansing 2865 Small show oil Increase oil 2892-93 T.D. 2896 7" 2890 WOC (Tel)
10/13	Drilled to T.D. 2904 Have 75 feet oil (Tel) in hole Will clean out and acidize
	OVER

10/17--Top Lansing 2865 T.D. 2904
Acidized with total 7000 gallons
Shut in 2 hours Ran swab and well
started flowing Flowed 129 bbls. oil
in 4 hours No water Next morning when
opened flowed 198 bbls. in 6 hours
On later gauge flowed 14 bbls. in 1 hour
2nd hour flowed 27 bbls.
3rd " " 19 "
4th & 5th hours flowed total 17 bbls.
Shut in tankage (Tel)

10/28 " " " " " "

11/1--Potential 1608 Barrels pumped (Telegram)

11/2 7" - 2890'.

Lans. 2865'.

T. D. 2904'.

8000 acid.

Potential 1608 bbls.

COMPLETED

Map No. 72 Sec. 32 Twp. 14 R. 13W

Well No. 4 Opdycke

Skelly

Company

Contractor

FIRST REPORT
NE NW


SECTION PLAT

330 Ft. from N. Line

_____ Ft. from S. Line

330 Ft. from E. Line

_____ Ft. from W. Line

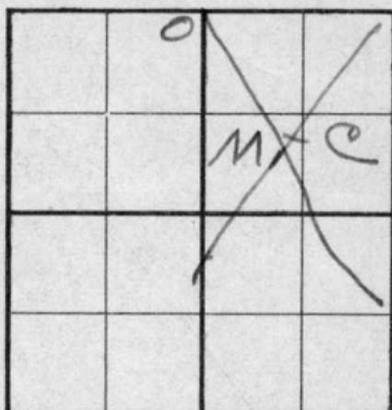

OFFSETS out #1 Rogg

Location _____

RECORD

Rig up _____

Drilling and Remarks:

Mov. in Tools

Cased _____ in., _____ ft.

Sand _____

Gas _____

Oil _____

Total Depth _____

PRODUCTION

1st 24 hrs. Nat. _____

1st 24 hrs. after shot _____

Gas _____ Cu. Ft.

Dry Hole _____

Abandoned _____

Date

SEP 14 1938 19 _____

H. D. Hatfield Scout

Map No. 72 Sec. 32 Twp. 14 R. 13W

Well No. 4 Opdycke

Skelly

Company

Contractor

COMPLETED

SECTION PLAT

NE NW

330 Ft. from N. Line

_____ Ft. from S. Line

330 Ft. from E. Line

_____ Ft. from W. Line

	0		

Location _____

Rig up _____

Drilling and Remarks:

8000 Acid

Pot 1608

RECORD

Cased 7 in., 2890 ft.

Sand LANS 2865

Gas _____

Oil _____

Total Depth 2904

PRODUCTION

1st 24 hrs. Nat. _____

1st 24 hrs. after shot _____

Gas _____ Cu. Ft.

Dry Hole _____

Abandoned _____

Date

NOV 2 - 1938

19

H. D. Hatfield

Scout