


Section 33 Township 16 Range 1W

Well No. #3 Stein "A"

Company F. S. Williams

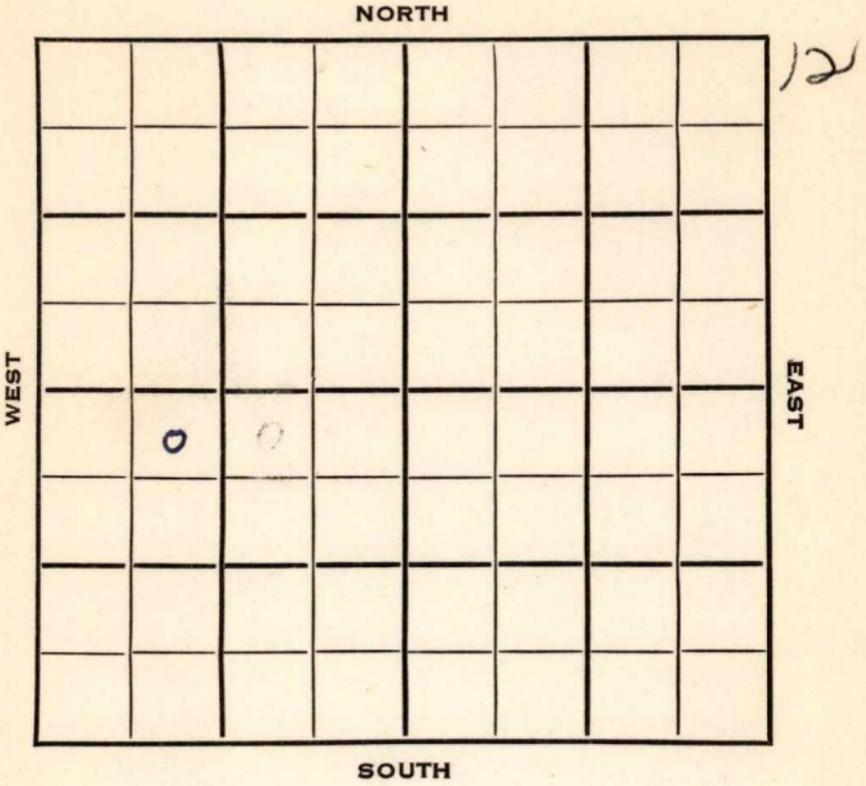

Sec. 33 Twp. 16 R. 1 W

Well No. # 3 Stein "A" Farm \_\_\_\_\_

F. S. Williams Company \_\_\_\_\_

Carey Contractor \_\_\_\_\_

N. Gypsum Creek Pool


330 Ft. from N. Line

\_\_\_\_\_ Ft. from S. Line

\_\_\_\_\_ Ft. from E. Line

990 Ft. from W. Line

NE NW SW

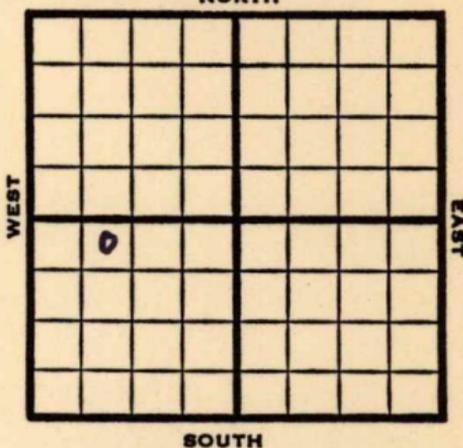

1953

Elv 1280'

REPORT

9/2 MIR

9/9 8" @ 125'

KC 1998'

DST 2012-21 1 hr, 35' Hlgocm, Miss 2602'

RTD 2605'

5" @ 2603'

9/16 NR

9/23 CO 2605 M & SSO DD 2612 1/2' TD

FU 1175' oil & 350' wtr. 20 1/2 hrs.

POP

9/30 N.R.

10/14 Spud 8-31-53 Oil well TD 2612

8" @ 125' KC 1998

DST 2012-21 open 1 hr rec 35' HOCM

Miss 2602' TD 2605' DD 2612

FU 1175' oil 350' wtr. 20 1/2 hr.

Comp. 25 BOPD 50% wtr.

**COMPLETED**



