

O.W.D.D KANSAS

Saline

Section 33 Township 16 Range 1-W

Well No. #4
#1 Stein

Company S
F F Williams

Gypsum Greek Pool
NORTH

WEST									EAST
	0								

SOUTH

13

KANSAS

Saline

✓✓
1W

Sec. 33 Twp. 16 R. 1W

Well No. #4 Stein Farm

F. R. Williams Company

Gypsum Creek


 Ft. from N. Line

330' Ft. from S. Line

 Ft. from E. Line

330' Ft. from W. Line

SW/C

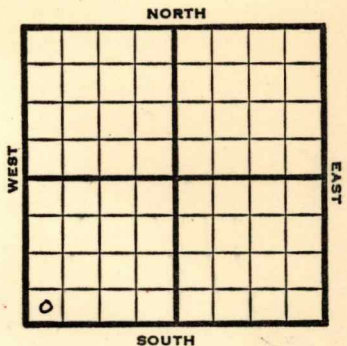

1948 Elev. 1280' REPORT

12/8 RUR
12/15 8" @ 122'
KC 2002
Drlg 2030'

12/22 Miss 2609'
TD 2643'

ABANDONED

1954 O.W.D.D

5/26 Miss 2609'
OTD 2643'
to DD

6/2 TD 2655' 5" @ 2654'

6/9 24/2612-18 S/2 BOPH POP

6/15 OilWell
TD 2655'
Miss 2609'
OTD 2632'
DD 2655'
5" @ 2654'
24/2612-18, S/2 boph
omp. 25 bopd 8 bw

COMPLETED

Map No. _____ Sec. 33 Twp. 16 R. 1W

Well No. 1 Stein

F. F. Williams Company

FIRST REPORT Contractor

SW/c


SECTION PLAT

_____ Ft. from N. Line

330 Ft. from S. Line

_____ Ft. from E. Line

330 Ft. from W. Line

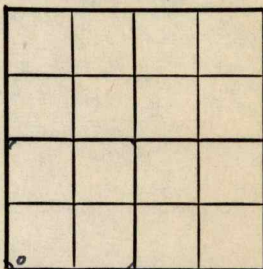

Saline County

Location _____

Rig up _____

Drilling and Remarks:

R U R

RECORD

Cased _____ in., _____ ft.

Sand _____

Gas _____

Oil _____

Total Depth _____

PRODUCTION

1st 24 hrs. Nat. _____

1st 24 hrs. after shot _____

Gas _____ Cu. Ft.

Dry Hole _____

Abandoned _____

Date

DEC 8 1948 19

S. J. LEWIS Scout

Map No. 42 Sec. 33 Twp. 16 R. 1W

Well No. 1 Stein

F. F. Williams Company

ABANDONED Contractor

SW/C


E. 1. 1280
SECTION PLAT

 Ft. from N. Line

330 Ft. from S. Line

 Ft. from E. Line

330 Ft. from W. Line

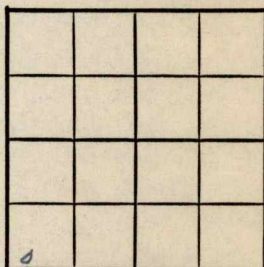

Saline County

Location

Rig up

Drilling and Remarks:

Misc 2609

RECORD

Cased in., ft.

Sand

Gas

Oil

Total Depth 2648

PRODUCTION

1st 24 hrs. Nat.

1st 24 hrs. after shot

Gas Cu. Ft.

Dry Hole

Abandoned

Date

DEC 22 1948 19

S. J. LEWIS Scout

Miss 2609 OTD 2643 to DD

J. G. McGEHEE

24/ 2612-18 S/ 2 boph Comp. 25 bopd 8