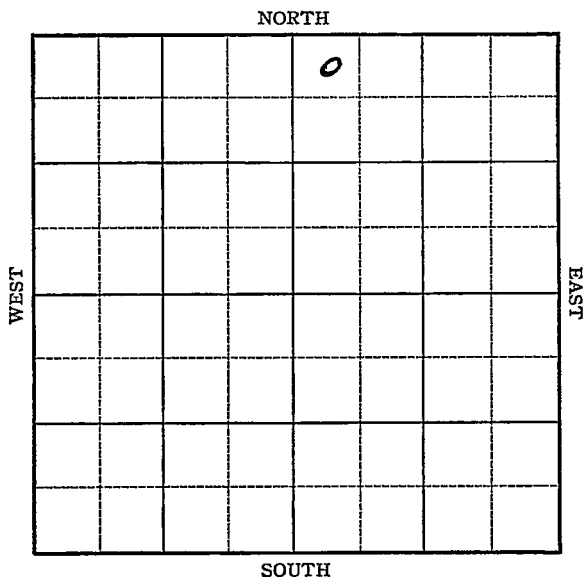


Barton

KANSAS

Section 34 Township 16 Range 13-WWell No. #2 ZuggCompany Stanolind

Barton KANSASMap No. _____ Sec. 34 Twp. 16 R. 1325Well No. 2 ZuggStandard Company

Contractor _____

FIRST REPORT

SECTION PLAT

		0	

330 Ft. from N. Line

_____ Ft. from S. Line

_____ Ft. from E. Line

330 Ft. from W. Line

Location _____

Rig up _____

Drilling and Remarks:

P.R.

RECORD

Cased _____ in., _____ ft.

Sand _____

Gas _____

Oil _____

Total Depth _____

PRODUCTION

1st 24 hrs. Nat. _____

1st 24 hrs. after shot _____

Gas ☒ _____ Cu. Ft.

Dry Hole _____

Abandoned _____

Date

SEP 22 1937

19

H. D. Hatfield

Scout

Barton

KANSAS

Map No. _____ Sec. 34 Twp. 16 R. 13WWell No. 2 Zugg

Stanolind Oil _____ Company

Contractor _____

COMPLETED

SECTION PLAT

NW NE

330 Ft. from N. Line

_____ Ft. from S. Line

_____ Ft. from E. Line

330 Ft. from W. Line

		0	

Location _____

Rig up _____

Drilling and Remarks:

POT-1814
NAT

RECORD

Cased 6 in., 3395 ft.Sand 511 3394

Gas _____

Oil _____

Total Depth 3398

PRODUCTION

1st 24 hrs. Nat. _____

1st 24 hrs. after shot _____

Gas _____ Cu. Ft.

Dry Hole _____

Abandoned _____

Date

NOV 3 1937

19

H. D. Hatfield

Scout