
Saline KANSAS

DX 78-1

Section 33 Township 16 Range 1W

Well No. 5 Stein

Company F. S. Williams

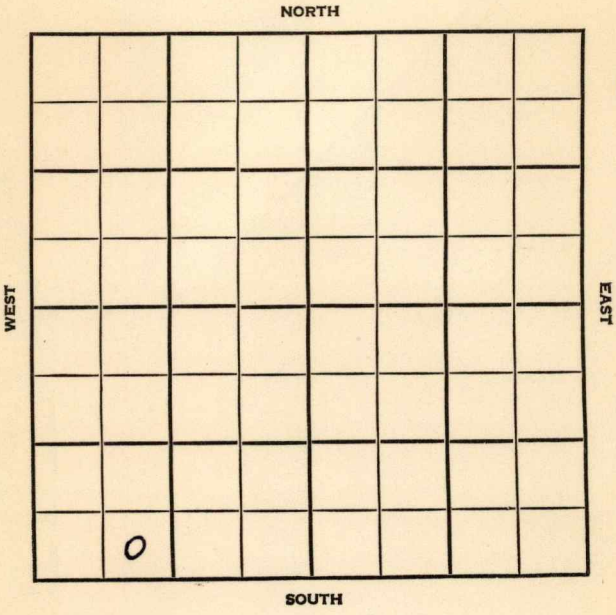

13

SEC.	TWP.	R.
33	16	1W

WELL NO. 5 Stein FARM

COMPANY F. S. Williams

CONTRACTOR Carey


Gypsum Creek Pool

____ Ft. from N. Line

330 Ft. from S. Line

____ Ft. from E. Line

990 Ft. from W. Line

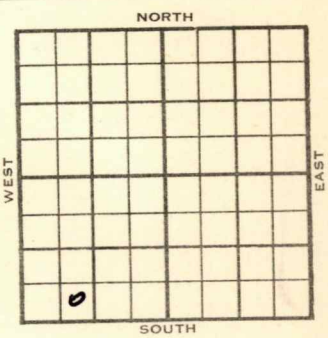

SE SW SW

1954	ELEVATION 1281' REPORT
6/8	R U R
6/23	8" @ 120' Doug 1840', Lans 2015', Miss 2608' RTD 2613' 5" @ 2611'
6/30	DD 2621' TD 8 BO + 50 BWPD SP 2100 24/2016-22 NS 24/2022-28
7/14	Spud 6-12-54 Oil well TD 2621 8" @ 120 Doug 1840 Lans 2015 Miss. 2608 TD 2613 5" @ 2611 DD 2621 8 BO 50 BWPD SP 2100 24/2016-22 24/2022-28 1½ BW 16 hr. CO to 2621 Comp. 8 BOPD 50 BW COMPLETED

DX-78

FORM 275 FOR SALE BY KANSAS BLUE PRINT CO.

County Saline State Kansas

Sec. 33 (Blk. Twp.) 16 (Sur. Rge.) 1W Map No.

Operator F. S. Williams

Well No. 5 Farm Stein

Elev. Location SE SW SW



330 Ft. From S Line SW

990 Ft. From W Line Quarter

1st. Report JUN 9 1954

Completion

Remarks

Carey - Contr.

Spudding Date

Drlg. Data Gypsum Creek Pool

RUR

J. G. McGEHEE

FORM 275 FOR SALE BY KANSAS BLUE PRINT CO.

County Saline State Kansas

Sec. 33 (Blk. Twp.) 16 (Sur. Rge.) 1W Map No.

Operator F. S. Williams

Well No. 5 Farm Stein

Elev. 1281 Location SE SW SW



330 Ft. From S Line SW

990 Ft. From W Line Quarter

1st. Report

Completion JUL 14 1954

Remarks Gypsum Creek Pool
Carey - Contr.

Spudding Date 6-12-54

Drlg. Data Oil well TD 2621

8" @ 120 Doug. 1840 Lans. 2015

Miss. 2608 TD 2613 5" @ 2611 DD 2621

8 bo 50 bwpd SP 2100 24/ 2016-22

24/ 2022-28 1½ bw 16 hr. CO to 2621

Comp. 8 bopd 50 bw

J. G. McGEHEE