

KANSAS

Barton

FORM 51 5M PETROL

Section 35 Township 16 Range 13W

Well No. 2 Gage

Company Skelly

NORTH

	0						

SOUTH

WEST

EAST

KANSAS

Barton County

Sec. 35 Twp. 16 R. 13W

Well No. 2 Gage Farm

Skelly Company

Ainsworth


Ft. from N. Line

330 Ft. from S. Line

Ft. from E. Line

990 Ft. from W. Line

SE SW SW Elev. 1871

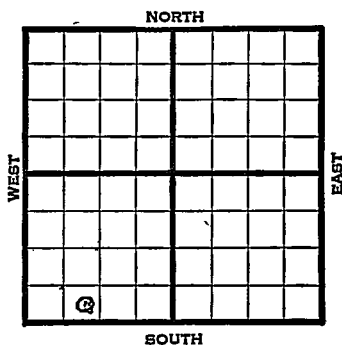

REPORT

1945

4/25 Location
5/3 RUR
5/10 40' Drlg.
5/17 8" @ 785
Drlg. 861
5/24 Drlg. 2510
5/31 Drlg. 3159
6/8 Topeka 2708 Lans 3074 Arb.
3314 TD 3319- 5" @ 3315 RUST
6/27 Arb. 3312
5" @ 3313
500 acid.
TD 3317'
Pump 338 Pot.
Grav. 39.0

COMPLETED


Kansas Pool Name AinsworthMap No. 73 Sec. 35 Twp. 16 R. 13WWell No. 2 Gage _____Skelly Company

FIRST REPORT

Contractor _____

SE SW SW

SECTION PLAT

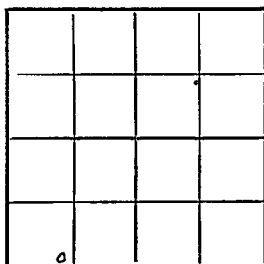

_____ Ft. from N. Line

330 Ft. from S. Line

_____ Ft. from E. Line

990 Ft. from W. Line

Barton County

Location X

Rig up _____

Drilling and Remarks:

RECORD

Cased _____ in., _____ ft.

Sand _____

Gas _____

Oil _____

Total Depth _____

PRODUCTION

1st 24 hrs. Nat. _____

1st 24 hrs. after shot _____

Gas _____ Cu. Ft.

Dry Hole _____

Abandoned _____


Date

APR 25 1945 19S. J. LEWIS

Scout

Kansas Pool Name AinsworthMap No. 73 Sec. 35 Twp. 16 R. 13WWell No. 2 GageSkelly CompanyCOMPLETED Contractor

SE SW SW

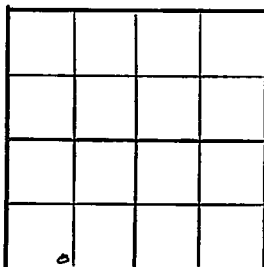E 11871
SECTION PLAT Ft. from N. Line330 Ft. from S. Line Ft. from E. Line990 Ft. from W. LineBarton CountyLocation Rig up

Drilling and Remarks:

At 3312.
5" 3313
500 acid
Run 338 1/2

39° 1/2

RECORD

Cased in., ft.Sand Gas Oil Total Depth 3317

PRODUCTION

1st 24 hrs. Nat. 1st 24 hrs. after shot Gas Cu. Ft.Dry Hole Abandoned

Date

JUN 27 194519S. J. LEWIS Scout