


Section 2 Township 16 Range 3-W

Well No. #1 Fox

Company Currier & Keyes

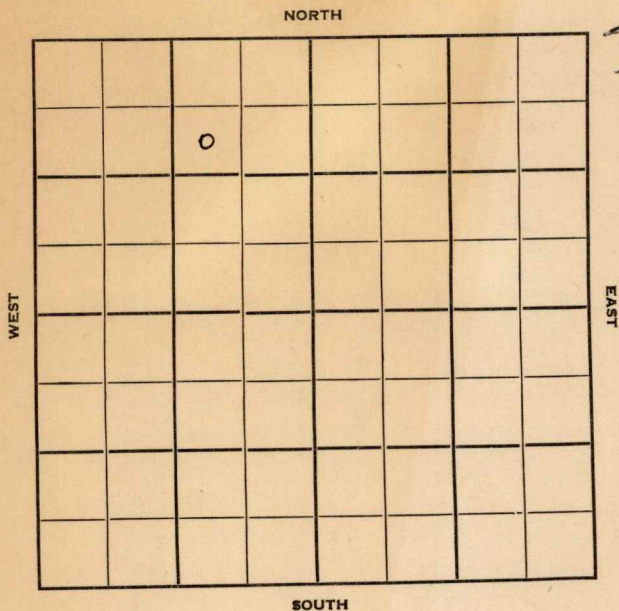

Saline

KANSAS

Sec. 2 Twp. 16 R. 3W

Well No. #1 Fox Farm

Currier & Keyes Company

E. K. Currier Contractor


990' Ft. from N. Line

 Ft. from S. Line

990' Ft. from E. Line

 Ft. from W. Line

SW NE NW

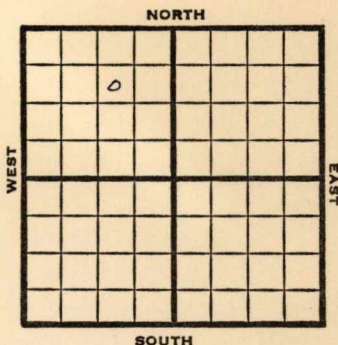

1950

Elev. 1290'

REPORT

3/1

Spud 2-26-50
8-5/8" @ 310'

5/24


8-5/8" @ 310'
KC 2220'
Miss 2826'
Kinderhook 3068'
Maq. 3303'
Viola 3357-78
DST 3352-78
Rec. heavy oil
5" @ 3369'
Comp. 50 BOPD
TD 3378'

COMPLETED

Kansas

Map No. _____ Sec. 2 Twp. 16 R. 3WWell No. 1 Fox_____
Currier & Keyes Company_____
E. K. Currier Contractor

SW NE NW

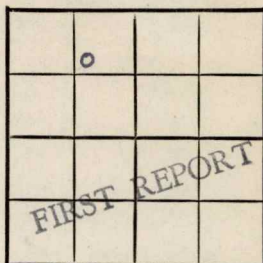El. 1290
SECTION PLAT_____
990 Ft. from N. Line_____
Ft. from S. Line_____
990 Ft. from E. Line_____
Ft. from W. Line_____
Saline County

Location _____

Rig up _____

Drilling and Remarks:

Spud 2-26-50

8 5/8" @ 310

RECORD

Cased _____ in., _____ ft.

Sand _____

Gas _____

Oil _____

Total Depth _____

PRODUCTION

1st 24 hrs. Nat. _____

1st 24 hrs. after shot _____

Gas _____ Cu. Ft.

Dry Hole _____

Abandoned _____

Date

MAR 1 1950

J. E. TYRA

Scout

Kansas

Map No. _____ Sec. 2 Twp. 16 R. 3WWell No. 1 FoxCurrier & Keyes Company_____
Contractor


SW NE NW

E1.1290
SECTION PLAT990 Ft. from N. Line

_____ Ft. from S. Line

990 Ft. from E. Line

_____ Ft. from W. Line

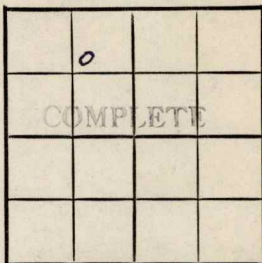

Saline

Location _____

Rig up _____

Drilling and Remarks:

8 5/8" C 310

K.C. 2220

Miss. 2826

Kinderhook 3068

Mag. 3303

Viola 3357-78

D.S.T. 3352-78

RECORD

Cased _____ in., _____ ft.

Sand _____

Gas _____

Oil _____

Total Depth 3378

PRODUCTION

1st 24 hrs. Nat. _____

1st 24 hrs. after shot _____

Gas _____ Cu. Ft.

Dry Hole _____

Abandoned _____

Date

MAY 24 1950

19

J. E. TYRA Scout

Rec. heavy oil
5" @ 3369
Comp. 50 bopd

Scout Cards
Land Small Map
Land Wall Map
Tracings
France Map
Pierce Map
Misc.

Drilling and Production
Bldg. no.
Location

NOV 5 1950

Cas
Seng
Cased

RECORD

EF from W. Line
EF from E. Line
EF from S. Line
EF from N. Line

SECTION PLAT

Contractor

Company

Well No.
Map No. Sec. S Twp. R