

Map No. KANSAS Sec. 14 Twp. 16 R. 2^W

Well No. 1 - Fulton Farm

Frank Dietrich Company

NORTH

WEST

EAST

SOUTH

Location _____

Drilling Remarks _____

Rig Up _____

Drilling Remarks _____

RECORD

Cased _____ in. _____ ft.

Sand _____

Gas _____

Oil _____

Total Depth _____

PRODUCTION

1st 24 hrs. Nat. _____

1st 24 hrs. after shot _____

Gas _____ cu. ft.

Dry Hole _____

Abandoned _____

Map No. **KANSAS** Sec. 14 Twp 16 R. 2^w

Well No. 1-Newton Farm

Frank Dieter Company

Harjo Oil & Co


 Ft. from N. Line

330 Ft. from S. Line

 Ft. from E. Line

330 Ft. from W. Line

1932

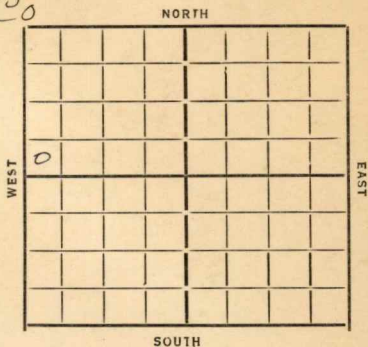

Date

REPORT

11/23

Pos.

11/30

12/1

12/14

12/21

12/28

1933

1/4

1/11

1/18

1/25

2/1

2/8

2/15

Blg rig

2/22

Rig

3/4

Spud - 140'

3/8

15" - 373' Wrlg 510'

3/12

Wrlg 1325'

3/22

12" - 1442 Wrlg 1965

3/29

Top K.C. limb 2215' H.F.W. 2325'

running 16" - 2335'

4/4

10" 2364 drly 2590

1933 8" 2770' Chat 2852 S.W.

4/12 —

4/19 —

4/26 u.p. 8"

5/4 8" 2852 N.7.W. 2890 S.W. 2900'

5/10 —

5/17 —

5/24 —

6/1 —

6/8 —

6/15 —

6/21 u.p. 8" to 2982 - 6" 3102 Top of Hunter 3252

July 3261 N.7.W.

6/28' July 3315'

7/12 - N. + a. 3579

ABANDONED

Saline

42

KANSAS

Map No. Sec. 14 Twp. 16 R. 2

Well No. 1

Fulton

Francis Dieter Company

Contractor

FIRST REPORTS

Ft. from N. Line

330 Ft. from S. Line

Ft. from E. Line

330 Ft. from W. Line

SECTION PLAT

0			

Location

Rig up

Drilling and Remarks:

Pr. o. G.

RECORD

Cased in., ft.

Sand

Gas

Oil

Total Depth

PRODUCTION

1st 24 hrs. Nat.

1st 24 hrs. after shot

Gas Cu. Ft.

Dry Hole

Abandoned

Date

NOV 23 1932

CHAS. L. SHERWOOD

192

Scout

Saline

42 KANSAS
 Map No. _____ Sec. 14 Twp. 16 R. 2^W

Well No. 1 Fulton
 Lario Oil & Gas Co. Company

Contractor

CORRECTION

_____ Ft. from N. Line

330 _____ Ft. from S. Line

_____ Ft. from E. Line

330 _____ Ft. from W. Line

SECTION PLAT

0			

Location _____

Rig up _____

Drilling and Remarks:

Chg Ownership
 to above.

RECORD

Cased _____ in., _____ ft.

Sand _____

Gas _____

Oil _____

Total Depth _____

PRODUCTION

1st 24 hrs. Nat. _____

1st 24 hrs. after shot _____

Gas _____ Cu. Ft.

Dry Hole _____

Abandoned _____

Date

FEB 1 1933

192

CHAS. L. SHERWOOD

Scout

Saline
 Map No. _____ Sec. 14 Twp. 16 R. 2W
 42
 Well No. 1 - Fulton
 Jarvis Oil + Gas Company
 Contractor


SECTION PLAT

Ft. from N. Line

330 Ft. from S. Line

Ft. from E. Line

330 Ft. from W. Line

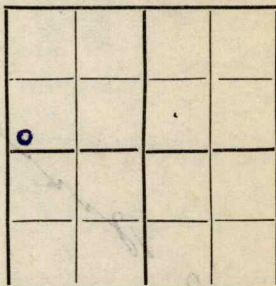

ABANDONED

Location _____

Rig up _____

Drilling and Remarks:

10 + 7

RECORD

Cased _____ in., _____ ft.

Sand _____

Gas _____

Oil _____

Total Depth 3579

PRODUCTION

1st 24 hrs. Nat. _____

1st 24 hrs. after shot _____

Gas _____ Cu. Ft.

Dry Hole _____

Abandoned _____

Date

7/12/33 192 Owal Mannedick Scout