


Section 35 Township 16 Range 13-N


Well No. #1 M. Deal

Company Stanolind

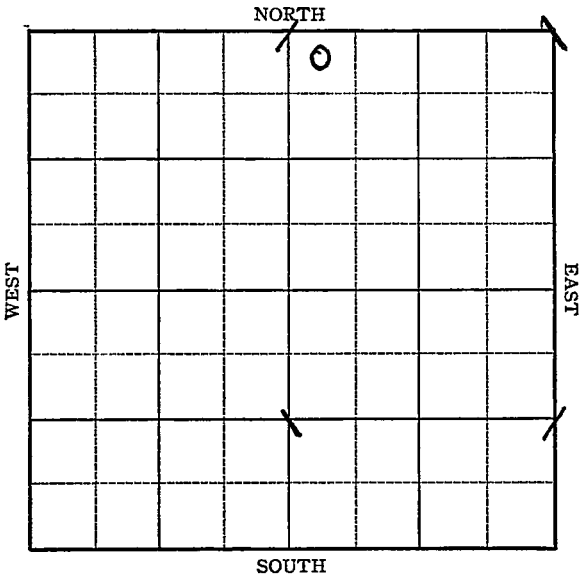

Sec. 35 Twp. 16 R. 13WWell No. 1-M. Deal FarmStanolind Company330 Ft. from N. Line Ft. from S. Line Ft. from E. Line330 Ft. from W. Line

Elev. 1937

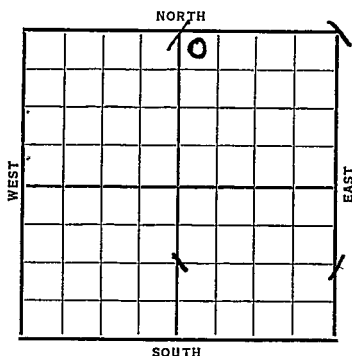

Date

REPORT

1937

8/11

Location

8/20

R. U. R.

8/28

10" @ 227'. Drlg. 960'.

9/3

Drlg. 2210'.

9/10

K.C. 3160' no show reported.

Cong. 3397'. Sil. 3399'.

6" @ 3400'. WOC. No shows

reported.

9/17

Sat. 3403-06'. C.O.

9/24

" " "

10/2

T.D. 3410'. ~600' oil 6 hrs.

300 acid. Swab 3 BOPH.

600 acid.

10/8

2100 acid. Swabbing 30 BOPH.

OVER

1937

10/13 6" @ 3400'.

Sil. 3399'.

T.D. 3410'.

3000 acid (Total)

Potential 886 bbls.

COMPLETED

Barton KANSASMap No. 73 Sec. 35 Twp. 16 R. 13WWell No. 1-M. DealStanoline Company

Contractor

FIRST REPORT

SECTION PLAT

530 Ft. from N. Line

_____ Ft. from S. Line

_____ Ft. from E. Line

330 Ft. from W. Line

		10	

Location ✓

Rig up _____

Drilling and Remarks:

RECORD

Cased _____ in., _____ ft.

Sand _____

Gas _____

Oil _____

Total Depth _____

PRODUCTION

1st 24 hrs. Nat. _____

1st 24 hrs. after shot _____

Gas _____ Cu. Ft.

Dry Hole _____

Abandoned _____

Date

AUG 11 1937 19H. D. Hatfield Scout

Barton

KANSAS

Map No. _____ Sec. 35 Twp. 16 R. 13WWell No. 1 May DealStanolind

Company

Contractor

COMPLETED

NW NE

330 Ft. from N. Line

_____ Ft. from S. Line

_____ Ft. from E. Line

330 Ft. from W. Line**SECTION PLAT**

		0	

Location _____

Rig up _____

Drilling and Remarks:

3000 Acid (Total)POT- 886**RECORD**Cased 6 in., 3400 ft.Sand 511 3399

Gas _____

Oil _____

Total Depth 3410**PRODUCTION**

1st 24 hrs. Nat. _____

1st 24 hrs. after shot _____

Gas _____ Cu. Ft.

Dry Hole _____

Abandoned _____

Date

OCT 13 1937

19

H. D. Hatfield

Scout

First report shows 35-16-13W.

Yours truly,

Paul.

OK now

HOK
i

ROH

Returned

Cards

Trac

1

Sec

1

Source

Mcc

Paul
Gm
HOK

4 p't + book

ok