



Sec. 2 Twp. 16 R. 3-W

Well No. #2 Fox Farm

E K Carey et al Company

Carey Contractor

Olsson


\_\_\_\_\_ Ft. from N. Line

660 Ft. from S. Line

990 Ft. from E. Line

\_\_\_\_\_ Ft. from W. Line

C W L SE NW

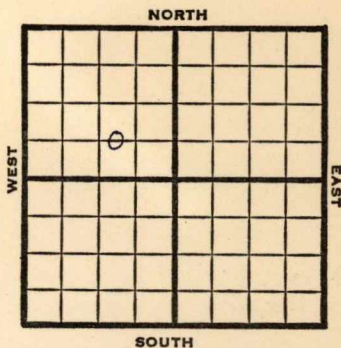

1950

Elev 1296

REPORT

10/11 Spud 10-6-50  
8 5/8" @ 302  
drlg 990

10/25 8 5/8" @ 302

KC 2176 Miss 2804  
Miss lime 2829 Kinderhook 3088

Hunton 3246 Maq 3256

Dol. 3326 Viola 3374

Pay 3389-3400

DST 3389-93 opn 1 hr rec 155' fluid  
(25' oil 10' socm 120' sw)

DST 3389-3404 opn 1 hr 45 min  
rec 10' hocm

60' ocm 120' socm 60' wcm

60' sw

TD 3404

D&A

**ABANDONED**



County Saline State Kansas

Sec. 2 (Blk.) 16 (Sur.) 3W Map No.

Operator E. K. Carey etal.

Well No. 2 Farm Fox

Elev. 1296 Location C W L SE NW



660 Ft. From S Line NW  
990 Ft. From E Line Quarter

1st. Report  
Completion OCT 25 1950  
Remarks Olsson Pool  
Carey - Contr.  
Spudding Date 10-6-50

Drlg. Data D & A TD 3404

8 5/8" @ 302 KC 2176 Miss. 2804  
Miss. line 2829 Kinderhook 3088  
Hunton 3246 Maq. 3256 Dol. 3326  
Viola 3374 Pay 3389-3400 DST 3389-93  
open 1 hr. Rec. 155' fluid (25' oil  
10' socm 120' sw) DST 3389-3404  
open 1 hr. 45 min. Rec. 10' hocm  
60' ocm 120' socm 60' wcm 60' sw

D & A