


Section 2 Township 16 Range 3-W

Well No. #3 Bjorklund

Company Spaeth Bros & Snyder

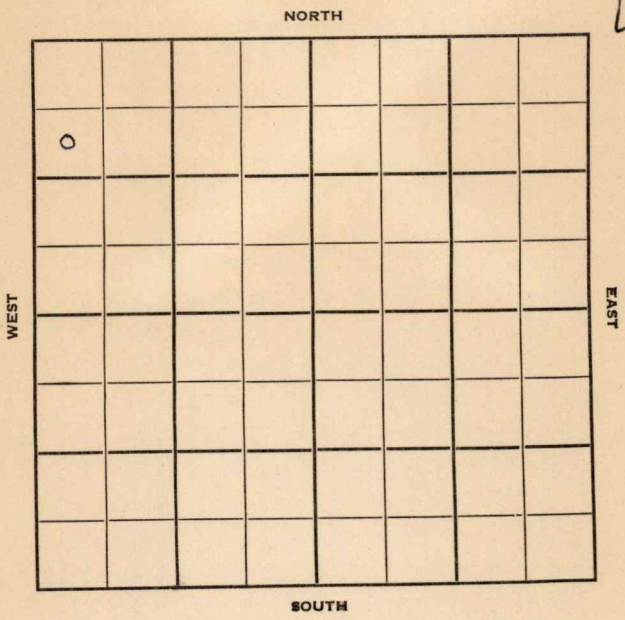

Sec. 2 Twp. 16 R. 3W

Well No. #3 Bjorklund Farm

Spaeth Bros. & Snyder Company

E. K. Carey - Contr. Contractor

Olsson Pool


1040' Ft. from N. Line

_____ Ft. from S. Line

_____ Ft. from E. Line

330' Ft. from W. Line

SW NW NW

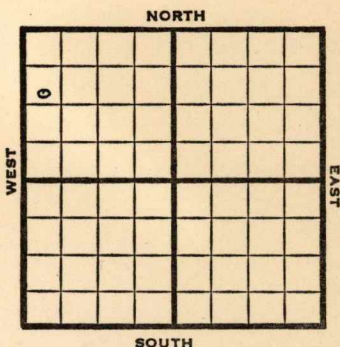

1950

Elv. 1289' REPORT

9/6

Spud 9-4-50
8-5/8" @ 290'

WOC

10/11

Spud 9-4-50
Oil Well TD 3377
8-5/8" @ 290' **Lans. 2167'**
Miss 2804' **Kinderhook 3060'**
Misener sd 3221' **Hunton 3222'**
Maq. sh 3232' **Maq. dol. 3295'**
Viola 3348' **Pay 3353-77'**
TD 3377'
DST 3363-77 opn 1/2 hr Rec. 580' drlg. mud
DST 3363-77 opn 3 hr. Rec. 520' hoem
540' oil & wtr 300' wtr & tr. of oil
5" @ 3377' 11/3361-65 800' wtr 200'
oil Fu 190' oil 690' wtr 14 hr.
PB 3364' 11/3360-64 FU 800' wtr
200' oil PB 3363 16/3357-61 8/3338-
-42 500 A SP 3327 32/3289-97
FU 250' oil 750' w Comp. 15 bopd
15 bwpd Gr. 36

COMPLETED

County **Saline** State **Kansas**

Sec. **2** (Blk.) **16** (Sur.) **3W** Map No.

Operator **Spaeth Bros. & Snyder**

Well No. **3** Farm **Bjorklund**

Elev. **1289** Location **SW NW NW**

0							

1040 Ft. From **N** Line **NW**
330 Ft. From **W** Line **Quarter**

Ist. Report **SEP 6 1950**

Completion

Remarks

Spudding Date **9-4-50**

Drlg. Data **Olsson Pool**

8 5/8" @ 290 WOC

County Saline State Kansas

Sec. 2 (Blk. 16) (Sur. Rge.) 3W Map No. _____

Operator Spaeth Bros. & Snyder

Well No. 3 Farm Bjorklund

Elev. 1289 Location SW NW NW

0							
COMPLETE							

1040 Ft. From N Line NW
330 Ft. From W Line Quarter

1st. Report

Completion OCT 11 1950

Remarks NE Olsson Pool

E. K. Carey - Contr.

Spudding Date 9-4-50

Drlg. Data Oil well TD 3377

8 5/8" @ 290 Lans. 2167 Miss. 2804

Kinderhook 3060 Misener sd. 3221

Hunton 3222 Maq. sn. 3232 Maq. dol. 3295

Viola 3348 Pay 3363-77 TD 3377

DST 3363-77 open 1/2 hr. Rec. 580' drlg. mud

DST 3363-77 open 3 hr. Rec. 520' nocm

540' oil & water 300' water & tr. of oil

5" @ 3377 11/ 3361-65 800' water 200' oil

FU 190' oil 690' water 14 hr. PB 3364

11/ 3360-64 FU 800' water 200' oil

PB 3363 16/ 3357-61 8/ 3338-42 500 A

SP 3327 32/ 3289-97 FU 250' oil 750' w

Comp. 15 bopd 15 bwpd 36 gr.

J. E. TYRA