


Section 10 Township 15 Range 13W

Well No. #1 Michel

Company ~~Von Feldt~~ C.L. Hanes  
*Trapp*

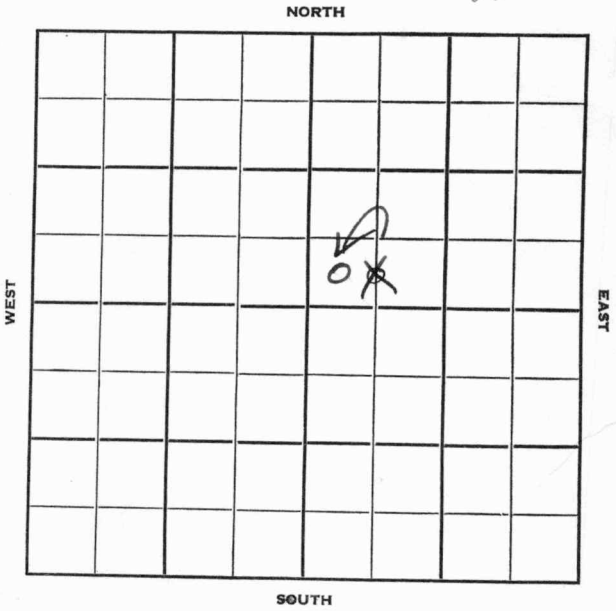

O.W.W.O. Russell

Sec. 10 Twp. 15 R. 13W

Well No. #1 Michel Farm

~~Von Feldt~~ C. L. Hanes Company

Contractor  
Trapp


         Ft. from N. Line

330' Ft. from S. Line

         Ft. from E. Line

330  
~~660'~~ Ft. from W. Line

~~C S/2 SW NE~~  
**SW SW NE**

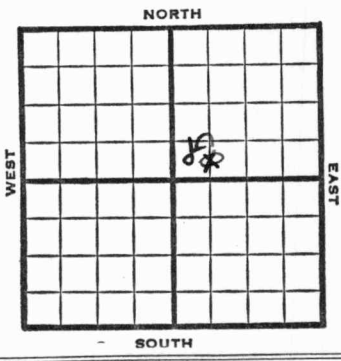

1951 Elev. 1849' **REPORT**

10/17 Spud 10-12-51  
Drlg. 50'

1952  
2/6 TD 2490 7" @ 2478'

2/13 TD 2495 PB 2485  
Pulling csg.

2/20 Spud 10-12-51  
Oil well TD 2495'  
12" @ 470' Anhy 805' 10" @ 808  
8" @ 2052 Tarkio 2480' 7" @ 2478'  
TD 2495' PB 2485' Hydro  
S/30 BCPD  
Comp. 25 BOPD

**COMPLETED**

1955  
O.W.W.O.

9-21 Old Info.- OTD 2495;  
7" 2478; was Tarkio prod.

New Info- RTD 3317; set liners to pipe  
set 900' of 4 1/2" liner at 3317 w/150 sx

- WOCT**
- Tops: Tark. 2480
  - Tp 2722
  - H. 2951
  - Tr. 2969
  - L. 3028
  - C. 3306
  - A 3316

**OVER**

1955

10/12

OTD 2495

7<sup>th</sup> @ 2478

Tarkio

2480

Tp

2722

H

2951

Tr

2969

L

3028

C

3306

A

3316

TD

3317

DD3317 DD 3322 B/6 goph 500 A

P/3 $\frac{1}{2}$  boph 8 hr

Comp 50 bopd

**COMPLETED**

County Russell State Kansas

Sec. 10 (Blk. Twp.) 15 (Sur. Rge.) 13W Map No.

Operator Von Feldt

Well No. 1 Farm Michel

Elev. \_\_\_\_\_ Location C S/2 SW NE

FIRST REPORT					

330 Ft. From S Line NE

660 Ft. From W Line Quarter

1st. Report OCT 17 1951

Completion \_\_\_\_\_

Remarks \_\_\_\_\_

Spudding Date 10-12-51

Drlg. Data Trapp

Drlg. 50

County Russell State Kansas

Sec. 10 (Blk. Twp.) 15 (Sur. Rge.) 13W Map No.

Operator Von Feldt

Well No. 1 Farm Michel

Elev. 1849 Location SW NE



330 Ft. From S Line NE

330  
660 Ft. From W Line Quarter

1st. Report

Completion FEB 20 1952

Remarks Trapp Pool

Spudding Date 10-12-51

Drilg. Data Oil well TD 2495

12" @ 470 Anhy 805 10" @ 808

8" @ 2052 Tarkio 2480 7" @ 2478

TD 2495 PB 2485 Hydro. S/ 30 bopd

Comp. 25 bopd

1st report shows 330 So. Line  
660 W. Line

This ticket shows 330 x 330

Please let us know if you want  
this correct. You do not say so and  
have never sent us a correction ticket

Advise

Sam

Scout Cards	.....
Land Small Map	.....
Land Wall Map	.....
Tracings	.....
France Map	.....
Pierce Map	.....
Misc	.....

FEB 25 1952

Orig. Data

Kansas

Map No. \_\_\_\_\_ Sec. 10 Twp. 15 R. 13W

Well No. 1 Michel

Von Feldt Company

**CORRECTION**

Contractor

SW SW NE

SECTION PLAT

\_\_\_\_\_ Ft. from N. Line

330 Ft. from S. Line

\_\_\_\_\_ Ft. from E. Line

330 Ft. from W. Line

		0	

Russell County

Location \_\_\_\_\_

Rig up \_\_\_\_\_

Drilling and Remarks:

Reported

C S L SW NE

RECORD

Cased \_\_\_\_\_ in., \_\_\_\_\_ ft.

Sand \_\_\_\_\_

Gas \_\_\_\_\_

Oil \_\_\_\_\_

Total Depth \_\_\_\_\_

PRODUCTION

1st 24 hrs. Nat. \_\_\_\_\_

1st 24 hrs. after shot \_\_\_\_\_

Gas \_\_\_\_\_ Cu. Ft.

Dry Hole \_\_\_\_\_

Abandoned \_\_\_\_\_

Date

J. G. McGEHEE

FEB 27 1952

19

Scout

O.W.W.O.

O.W.W.O.

County Russell Elev. \_\_\_\_\_  
 Sec. 10 Twp. 15S Rge. 13W  
 Company C. L. Hanes  
 Farm Name Michel No. 1

TOPS	DEPTH	LOG	DATUM	Loc. in Sec.
Anh. <u>Tark.</u>	<u>2480</u>			<u>SW SW NE</u>
TP.	<u>2722</u>			
H.	<u>2951</u>			
Tr.	<u>2969</u>			
Dg.				
BL.				
L.	<u>3028</u>			
K.C.				Geol. _____
B.K.C.				Contr. _____
Ce.				
C.	<u>3306</u>			
M.				
M.				Pool
K.				<u>Trapp</u>
Mz.				
Me.				
V.				
S.				
S.	<u>3316</u>			
A.				
R.				
PE.				
G.				
TD.				

O.W.W.O.

FIRST REPORT  
 SEP 21 1956

Date Comm. Old info - OTD 2495; 7" 2478;  
was Tarkio prod.

New info - RTD 3317; set liners to pipe  
set 990' of 4 1/2" liner at 3317 w/150 sx;  
WOCT

13

Co.  
Lse.  
No.  
Sec.  
T.  
R.

County Russell Elev. 1849  
 Sec. 10 Twp. 15 Rge. 13W  
 Company C. L. Hanes  
 Farm Name Michel No. 1

TOPS	DEPTH	LOG	DATUM
Anh. <u>Larkin</u>	<u>2480</u>		<u>631</u>
T.P.	<u>2722</u>		<u>873</u>
H.	<u>2951</u>		<u>1102</u>
Tr.	<u>2969</u>		<u>1120</u>
Dg.			
Bl.			
L.	<u>3028</u>		<u>1179</u>
K.C.			
B.K.C.			
Ce.			
C.	<u>3306</u>		<u>1457</u>
M.			
M.			
K.			
Mz.			
Ma.			
V.			
S.			
S.			
A.	<u>3316</u>		<u>1467</u>
R.			
PE.			
G.			
T.B.	<u>3317</u>		

Loc. in Sec. SW SW NE

Geol. \_\_\_\_\_

Contr. \_\_\_\_\_

Pool Trapp



Date Comm. OCT 12 1955

OTD 2495 7" @ 2478 DD 3317 DD 3322

B/ 6 goph 500 A. P/ 3 1/2 boph 8 hr.

Comp. 50 bopd

Co.

Lse.

No.

Sec.

T.

R.