


Section 35 Township 16 Range 13W

Well No. 3 Gage "A"

Company Skelly

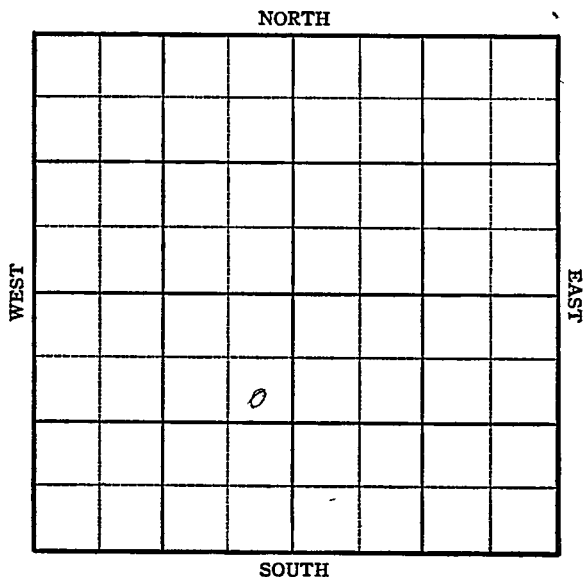

O. W. P. B.
Sec. 35 Twp. 16 R. 13W

KANSAS

Barton County

Well No. #3 Gage "A" Farm


Skelly Company
Susank

990 Ft. from N. Line

 Ft. from S. Line

330 Ft. from E. Line

 Ft. from W. Line

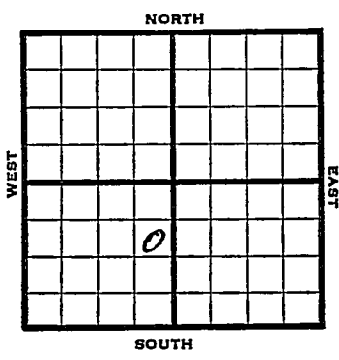

SE NE SW

REPORT	
1945	Elev. 1906
10/31	Drlg. 400'
11/7	10" @ 797 Anhy 817 Drlg. 1120'
11/14	Drlg. 3026'
11/21	Lans 3117 Arb. 3363 3366 fsg.
11/28	" " "
12/6	Arb. 3363 Lost hole TD 3366 Abandoned
ABANDONED	
1954	O. W. P. B.
3/17	Oil well TD 3374 Top. 2735' Heeb 3019 Tor. 3036 Lans. 3122 Cong. 3349 Arb. 3364 5" @ 3365 OTD 3374 SP 3358 72/3346-54 500 A P/69 BW 16 hr. SP 3340 12/3330-34 FU 1650' wtr. 1½ hr. PB 3328' 78/3321-27 1800 A PB 3280 18/3260-62 45/3251-56 18/3247-49 500 A S/24 BO 23 BW 18 hr. 1500 A S/53 BO 72 BWPD PB 3242' 45/3231-36 500 A S/8 BO VSSW 3 hr.
OVER	

1954
3/17

(Information continued)

PB 3056 99/3036-47 500 A

126/2946-60 500 A B/ $\frac{1}{2}$ BWPB 2 hr.

CO to 3280 Comp. 5 BOPD 12 BW

FIRST REPORT

+

COMPLETED

KANSAS Kansas Pool Name SusankMap No. 73 Sec. 35 Twp. 16 R. 13WWell No. 3 GageSkelly

Company

FIRST REPORT

Contractor

SE NE SW

SECTION PLAT

990 Ft. from N. Line Ft. from S. Line330 Ft. from E. Line Ft. from W. LineBarton CountyLocation Rig up

Drilling and Remarks:

400'

RECORD

Cased in., ft.Sand Gas Oil Total Depth

PRODUCTION

1st 24 hrs. Nat. 1st 24 hrs. after shot Gas Cu. Ft.Dry Hole Abandoned

Date

OCT 31 194519S. J. LEWISScout

KANSAS

Kansas Pool Name SusankMap No. K-23 Sec. 35 Twp. 16 R. 13WWell No. 3 GageSkelly Company

ABANDONED

Contractor

SE NE SW

E1/1906

SECTION PLAT.

990 Ft. from N. Line Ft. from S. Line Ft. from E. Line330 Ft. from W. Line

Barton County

Location Rig up

Drilling and Remarks:

*Art 3363**Lost Hole**Abandoned*

RECORD

Cased in., ft.Sand Gas Oil Total Depth 3366

PRODUCTION

1st 24 hrs. Nat. 1st 24 hrs. after shot Gas Cu. Ft.Dry Hole Abandoned

Date

DEC 5 1945 19 S. J. LEWIS Scout

O. W. P. B.

County	Barton		State	Kansas	
Sec.	35	(Blk. Twp.)	16	(Sur. Rge.)	13W Map No.
Operator	Skelly Oil				
Well No.	3	Farm	Gage "A"		
Elev.	1905	Location	SE NE SW		

FIRST REPORT

0 1/2

COMPLETE

990	Ft. From	N	Line	SW
330	Ft. From	E	Line	Quarter
1st. Report MAR 17 1954				
Completion MAR 17 1954				
Remarks OWPB				

~~C. W. P. B.~~

Drig. Data	Oil well	TD 3374	
Top. 2735	Heeb. 3019	Tor. 3036	
Lans. 3122	Cong. 3349	Arb. 3364	
5" @ 3365	OTD 3374	SP 3358	72/ 3346-54
500 A	P/ 69 bw	16 hr.	SP 3340
12/ 3330-34	PU 1650' wtr.	1½ hr.	
PB 3328	78/ 3321-27	1800 A	PB 3280
18/ 3260-62	45/ 3251-56	18/ 3247-49	
500 A	S/ 24 bo	23 bw	18 hr. 1500 A
S/ 53 bo	72 bwpd	PB 3242	45/ 3231-36
500 A	S/ 8 bo VSSW	3 hr.	PB 3056
99/3036-47	500 A	126/ 2946-60	500 A
B/ ½ bwph	2 hr.	CO to 3280	
Comp. 5 bopd	12 bw		

J. G. McGEHEE