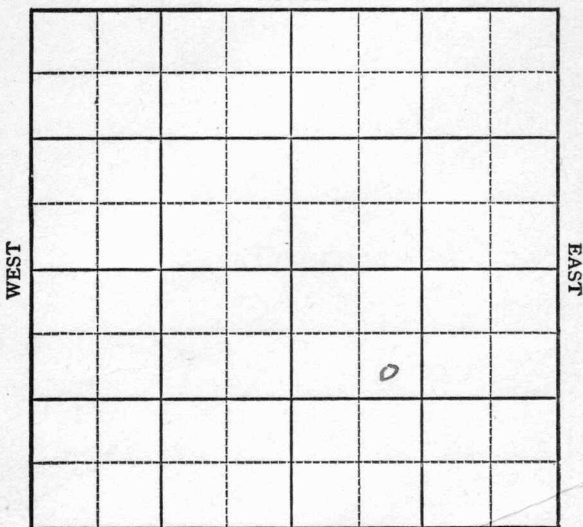


Section 6 Township 15 Range 13WWell No. 2 Berrick SWDCompany Murfin et alHall-Gurney Pool

NORTH



SOUTH

KANSAS

Russell

O.W.W.O. ✓

Sec. 6 Twp. 15 R. 13WWell No. #2 Berrick Farm

Murfin et al

Company

Hall-Gurney

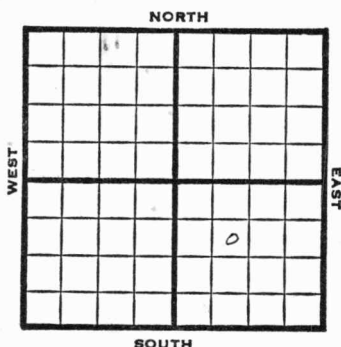
990' Ft. from N. Line

Ft. from S. Line

Ft. from E. Line

990' Ft. from W. Line

SE NW SE



1949

Elev 1831'

REPORT

1/5 8" @ 193'
Drlg. 1650'

1/12 Drlg 3235
1/19 Lansing 3026'
Arb. 3297-
TD 3303'
5"@ 3300'

1/26 "

2/2 HFW 3305
TD 3307'
42 shots 3045-60
5000 acid swb 1/2 bbl oil & 1/2 bbl
WPH

2/9 To acidize
HFW 3305-07
TD 3307'
42 shots 3045-60
5000 acid

2/16 Swb 1/2 bbl oil $\times$ 1/2 bbl W PH to re-acidize
5000 acid

2/23 150' oil
3/2 Swb 1/2 bbls oil PH
TD 3307'

Lans. 3026'

Arb. 3297'

5"@ 3300'

Perf Lans. 10000 acid

Pump 25 Oil Pot

40°

Comp^{gr}

COMPLETED

OVER

Kansas

Map No. _____ Sec. 6 Twp. 15 R. 13WWell No. 2 BerrickMurfin etal. CompanyFIRST REPORT Contractor

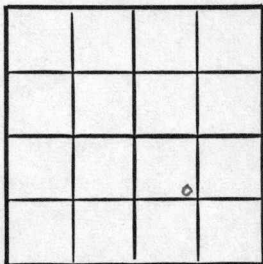
SE NW SE

SECTION PLAT

990 Ft. from N. Line

_____ Ft. from S. Line

_____ Ft. from E. Line

990 Ft. from W. LineRussell County

Location _____

Rig up _____

Drilling and Remarks:

8" @ 193

drlg. 1650

RECORD

Cased _____ in., _____ ft.

Sand _____

Gas _____

Oil _____

Total Depth _____

PRODUCTION

1st 24 hrs. Nat. _____

1st 24 hrs. after shot _____

Gas _____ Cu. Ft.

Dry Hole _____

Abandoned _____

Date

JAN 5 1949

19

S. J. LEWIS

Scout

Kansas

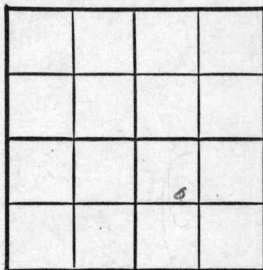
Map No. K73 Sec. 6 Twp. 15 R. 13WWell No. 2 BerrickMurfin et al.

Company

COMPLETE

Contractor

SE NW SE

E. 1/8 B1.
SECTION PLAT990 Ft. from N. Line Ft. from S. Line Ft. from E. Line990 Ft. from W. Line

Russell County

Location Rig up

Drilling and Remarks:

*L me 3826**CR 3297**5" @ 3300**Prof Lame**10000 acid**Run 25 in 1st**40-2-4***RECORD**Cased in., ft.Sand Gas Oil Total Depth 3307**PRODUCTION**1st 24 hrs. Nat. 1st 24 hrs. after shot Gas Cu. Ft.Dry Hole Abandoned

Date

MAR 2 1949 19

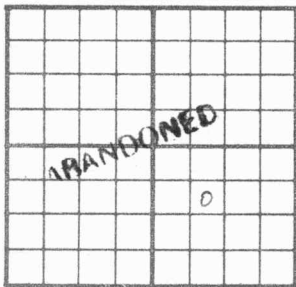
S. J. LEWIS

Scout

OTD 3307 DD @ 3460

J. G. McGEHEE

O.W.W.O.

County Russell State KansasSec. 6 (Blk.
Twp.) 15 (Sur.
Rge.) 13W Map No.Operator Murfin Drlg.Well No. 2 Farm Berrick SWDElev. 1831 Location SE NW SE990 Ft. From N Line SE990 Ft. From W Line Quarter1st. ReportCompletion JUL 16 1952Remarks OWWO

O.W.W.O.

Spudding DateDrlg. Data SWD well TD 3451Lans. 3026 Arb. 3297 5" @ 3300OTD 3307 DD 3451 corr. 4" liner @ 33422000 A Comp. for SWD well

J. G. McGENEE

1952

O.W.W.O.

6/18 Lans. 3026 Arb. 3297 Prod.
5" @ 3300' OTD 3307' DD @ 3460

6/25 NR

7/2 4" Liner @ 3454 DP

7/9 NR

7/16 SWD well TD 3451' Lans. 3026'
Arb. 3297' 5" @ 3300 OTD 3307'
DD 3451' corr. 4" liner @ 3342'
2000 A
Comp. for SWD well

ABANDONED