

KANSAS


FORM 51 5M PETROL

Saline

Section 3 Township 16 Range 3W

Well No. #1 Bengston

Company Margay

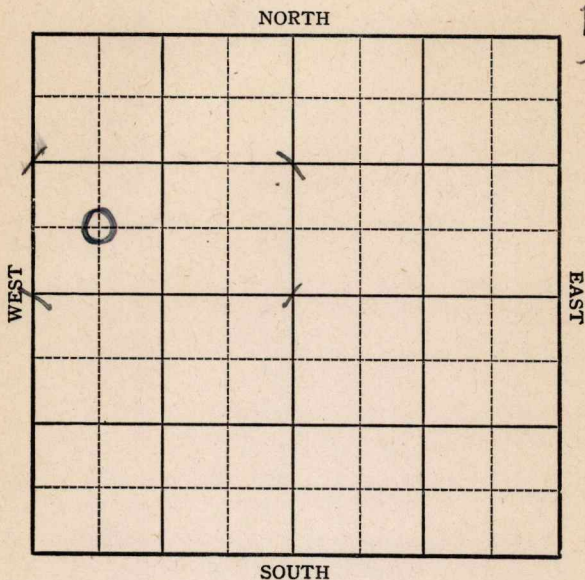

Sec. 3 Twp. 16 R. 3W

Well No. #1 Bengston Farm

Margay Company

Ollson


 Ft. from N. Line

660 Ft. from S. Line

 Ft. from E. Line

660 Ft. from W. Line

Elev. 1289

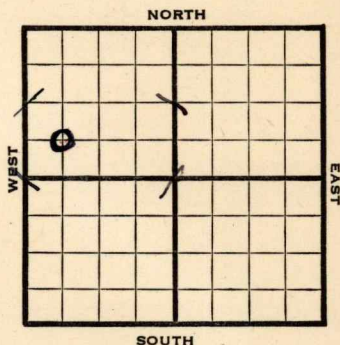

1944

REPORT

3/29

Location

4/5

Rotary

4/12

8" @ 309

WOC.

4/19

Lans 2160

Drlg. 2479'

4/26

Miss 2798

TD 3363

Run Casg.

5/3

Viola 3363-65 TD

5" @ 3363

Rust

5/10

Viola 3352 corrected

5" @ 3361 TD 3371

1000 acid 600' fluid in 21 hrs.

5/17

" " " "

5/24

Pump 27 oil show wtr 24 hrs.

5/31

" " " "

6/7

5" @ 3361

Viola 3350

TD 3371

Pump 8 oil and 57% wtr.

36.0 Gravity.

COMPLETED

Map No. KANSAS 42 Sec. 3 Twp. 16 R. 3W
Well No. 1 Bengston

Margay


Company

FIRST REPORT

Contractor

C SW NW

SECTION PLAT

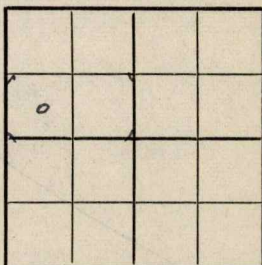 Ft. from N. Line660 Ft. from S. Line Ft. from E. Line660 Ft. from W. LineOllson PoolLocation XRig up Drilling and Remarks:

RECORD

Cased in., ft.Sand Gas Oil Total Depth

PRODUCTION

1st 24 hrs. Nat. 1st 24 hrs. after shot Gas Cu. Ft.Dry Hole Abandoned

Date

MAR 29 1944 19S. J. LEWIS Scout

KANSASPool Name OllsonMap No. 42 Sec. 3 Twp. 16 R. 3WWell No. 1 BengstonMargay CompanyCOMPLETED ContractorC SW NW

SECTION PLAT

o			

 Ft. from N. Line660 Ft. from S. Line Ft. from E. Line660 Ft. from W. LineSaline CountyLocation Rig up

Drilling and Remarks:

Viola 3350503361Pump Soil 457 7/8 Water36° S

RECORD

Cased in., ft.Sand Gas Oil Total Depth 3371

PRODUCTION

1st 24 hrs. Nat. 1st 24 hrs. after shot Gas Cu. Ft.Dry Hole Abandoned

Date

JUN 7 194419S. J. LEWIS Scout