


Section 35 Township 16 Range 13W

Well No. #1 Rieff

Company Anchultz Drlg.

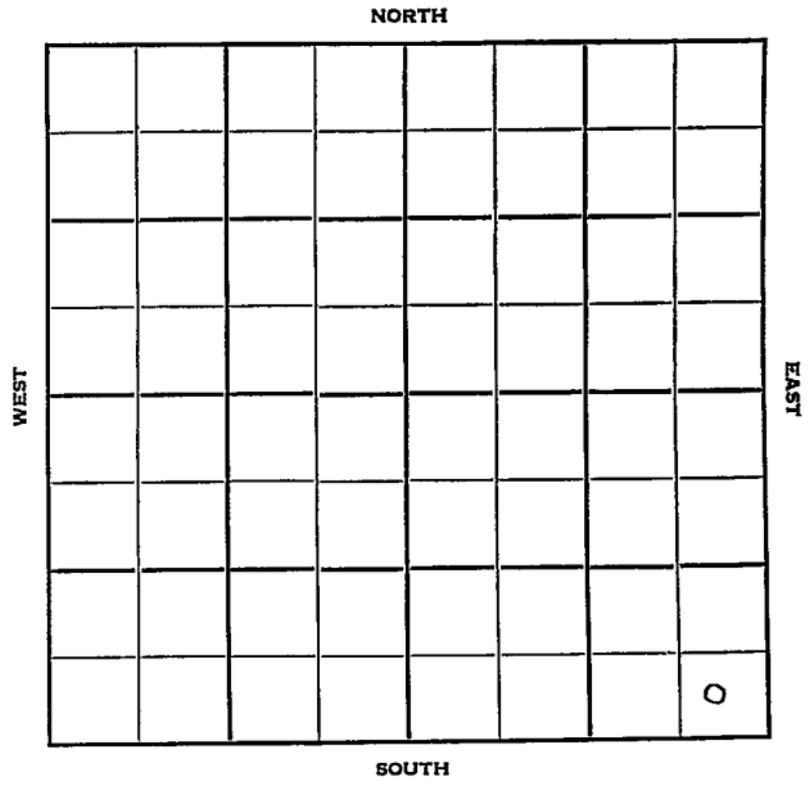

Barton **KANSAS**

Sec. 35 Twp. 16 R. 13W

Well No. #1 Rieff Farm

Anshultz Drlg. Company

Contractor

Wildcat


Ft. from N. Line

330' Ft. from S. Line

330' Ft. from E. Line

Ft. from W. Line

SE SE SE

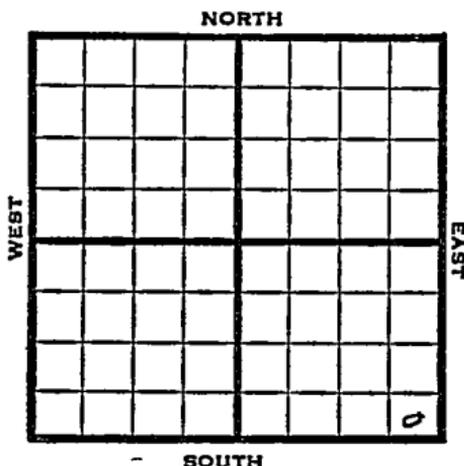

1951 Elev. 1892' REPORT

9/12 Cellar & Pits

10/3 Spud 9-17-51

D & A TD 3420' 8" @ 252'
 Anhy 800' Br. line 3110'
 Lans. 3127' Cong. 3370'
 Arb. 3398-3420' TD
 D & A

'ABANDONED

