


Section 35 Township 16 Range 13W

Well No. #1 Zuggy

Company Petroleum Inc.

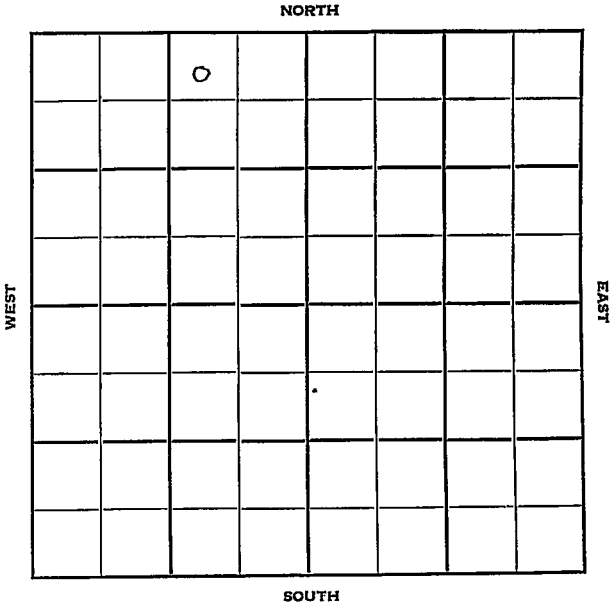

Barton KANSAS

Sec. 35 Twp. 16 R. 13W

Well No. #1 Zuggy Farm

Petroleum, Inc. Company

Garvey - Contr. Contractor

Trapp Pool


330' Ft. from N. Line

\_\_\_\_\_ Ft. from S. Line

990' Ft. from E. Line

\_\_\_\_\_ Ft. from W. Line

NW NE NW

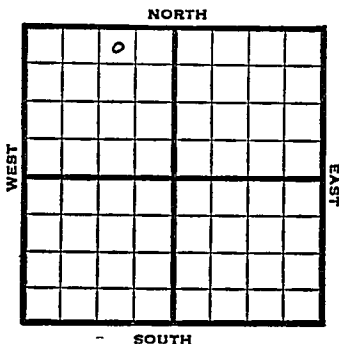

1951

Elev. 1932' REPORT

9/12

Spud 8-9-51  
8" @ 245  
Drlg. 2665'

10/10

Spud 8-9-51  
Oil well TD 3060  
8" @ 245'  
Anhy 830 Heeb. 3060 Br. Im. 3144  
Lans. 3156  
DST 3273-3301 open 1½ hr.  
Rec. 25' SOCM Arb. 3388-93  
DST 3390-93 open 45 min.  
Rec. 470' oil 5" @ 3389'  
TD 3393' FU 2100' oil 1¼ hr.  
Comp. 75 BOPD

**COMPLETED**

County Barton State Kansas

Sec. 35 (Blk. 16 (Sur. 13W (Twp.) (Rge.) Map No.

Operator Petroleum Inc.

Well No. 1 Farm Zugy

Elev. Location NW NE NW


FIRST REPORT

330 Ft. From N Line NW  
990 Ft. From E Line Quarter

1st. Report SEP 12 1951

Completion

Remarks Stanolind-DHM

Garvey - Contr.

Spudding Date 8-9-51

Drlg. Data Trapp - pool

8" @ 245 Drlg. 2665

County Barton State Kansas

Sec. 35 (Blk.) 16 (Sur. Rge.) 13W Map No.

Operator Petroleum Inc.

Well No. 1 Farm Zuggy

Elev. 1932 Location NW NE NW

		0			

330 Ft. From N Line NW

990 Ft. From E Line Quarter

1st. Report

Completion OCT 10 1951

Remarks Trapp Pool

Garvey Oil - Contr.

Spudding Date 8-9-51

Drlg. Data Oil well TD 3393

8" @ 245 Anhy 830 Heeb. 3060

Br. lime 3144 Lans. 3156 DST 3273-3301

open 1 1/2 hr. Rec. 25' socm Arb. 3388-93

DST 3390-93 open 45 min. Rec. 470' oil

5" @ 3389 TD 3393 FU 2100' oil 14 hr.

Comp. 75 bopd

Y Y Y

J. E. TYRA