


Barton

KANSAS

Section 1 Township 16 Range 14-W

Well No. 3 Ehrlich "B"

Company Shell

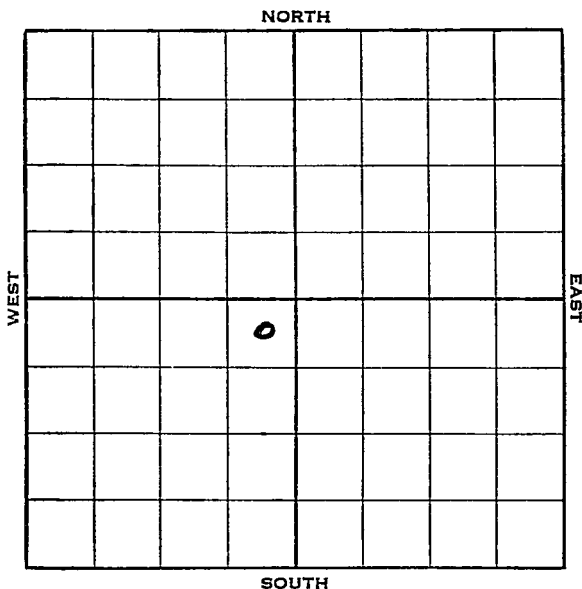


Sec. 1 Twp. 16 R. 14-WWell No. #3-Ehrlich "B" Farm _____Shell Company _____330 Ft. from N. Line

_____ Ft. from S. Line

330 Ft. from E. Line

_____ Ft. from W. Line

Elev. 1911

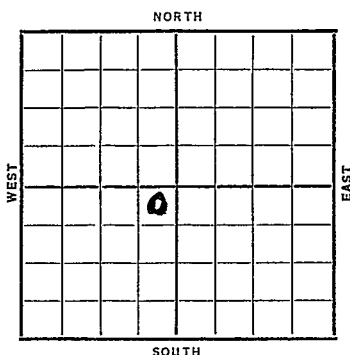

Date

REPORT

1938

7/13

B.R.R.

7/22

10" - 640'. Dlg. 648'.

7/29

Dr lg. 2860'.

8/5

Arb. 3335-37' S.O.

7" - 3336'. RUST.

8/10

7" - 3336'.

Arb. 3335'.

T. D. 3361'.

6000 acid.

Pump 424 bbls. 4 hrs. & 406 bbls.

4 hours.

Potential 2424 bbls.

COMPLETED

Barton KANSAS

Map No. 73 Sec. 1 Twp. 16 R. 14WWell No. 3 Ehrlich "B"Shell

Company

Contractor

FIRST REPORT

NE SW

330 Ft. from N. Line Ft. from S. Line330 Ft. from E. Line Ft. from W. Line

SECTION PLAT

	0		

Location Rig up

Drilling and Remarks:

BRR

RECORD

Cased in., ft.Sand Gas Oil Total Depth

PRODUCTION

1st 24 hrs. Nat. 1st 24 hrs. after shot Gas Cu. Ft.Dry Hole Abandoned

Date

JUL 13 1938

19

H. D. Hatfield Scout

Barton KANSAS

Map No. 73 Sec. 1 Twp. 16 R. 14WWell No. 3 Ehrlich "B"

Shell

Company

Contractor

COMPLETED

NE SW

330 Ft. from N. Line

Ft. from S. Line

330 Ft. from E. Line

Ft. from W. Line

SECTION PLAT

	0		

Location

Rig up

Drilling and Remarks:

6000 Acid

P-424/4 + 406/4

Pot 2424'

RECORD

Cased 7 in., 3336 ft.Sand Arb 33.35

Gas

Oil

Total Depth 3361

PRODUCTION

1st 24 hrs. Nat.

1st 24 hrs. after shot

Gas Cu. Ft.

Dry Hole

Abandoned

Date

AUG 10 1938 19

H. D. Hatfield

Scout