

KANZAS

Saline

Section 3 Township 16 Range 3W

Well No. 2 Anderson

Company Wakeeney - Syndicate

Olson

NORTH

14

WEST

EAST

			0				

SOUTH

Saline

KANSAS ✓

Sec. 3 Twp. 16 R. 3W

Well No. #2 Anderson Farm

Wakeeney - Syndicate Company

Olson Pool

 Ft. from N. Line

330'


 Ft. from S. Line

330'

 Ft. from E. Line

 Ft. from W. Line

SE SW

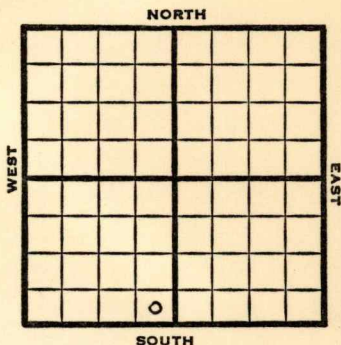

1949

Elev 1303'

REPORT

7/6
7/12

Location

8" @ 280'

Drlg 285'

7/20
7/27

Drlg 3095'

"

8/3

TD 3366'

Viola 3353'

5" @ 3354'

1000 acid

Pump 25 Oil Pot

36° Gr.

Comp

COMPLETED

Map No. _____ Sec. 3 Twp. 16 R. 3W

Well No. 2 Anderson

Wakeeney - Syndicate Company

Sterling Drlg. Contractor

SE SW


FIRST REPORT
SECTION PLAT

_____ Ft. from N. Line

330 Ft. from S. Line

330 Ft. from E. Line

_____ Ft. from W. Line

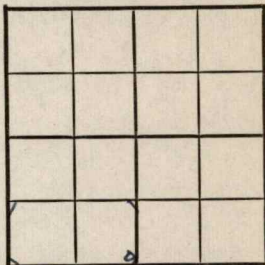

Saline County

Location X

Rig up _____

Drilling and Remarks:

RECORD

Cased _____ in., _____ ft.

Sand _____

Gas _____

Oil _____

Total Depth _____

PRODUCTION

1st 24 hrs. Nat. _____

1st 24 hrs. after shot _____

Gas _____ Cu. Ft.

Dry Hole _____

Abandoned _____

Date

JUL 6 1949

S. J. LEWIS Scout

Olson Pool

Map No. K42 Sec. 3 Twp. 16 R. 3W

Well No. 2 Anderson

Wakeney-Syndicate Company

COMPLETE

Contractor

SE SW

E. 1303


SECTION PLAT

 Ft. from N. Line

330 Ft. from S. Line

330 Ft. from E. Line

 Ft. from W. Line

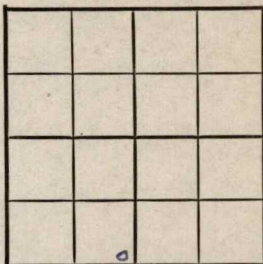

Saline County

Location

Rig up

Drilling and Remarks:

Vista 3353
5" @ 3354
1000 acid
Pump 25 oil P.D.
36-2-4

RECORD

Cased in., ft.

Sand

Gas

Oil

Total Depth 3366

PRODUCTION

1st 24 hrs. Nat.

1st 24 hrs. after shot

Gas Cu. Ft.

Dry Hole

Abandoned

Date

AUG 3 1949

S. J. LEWIS Scout