


Section 22 Township 14 Range 13W

Well No. #2 Jones (B)

Company Duke & Wood

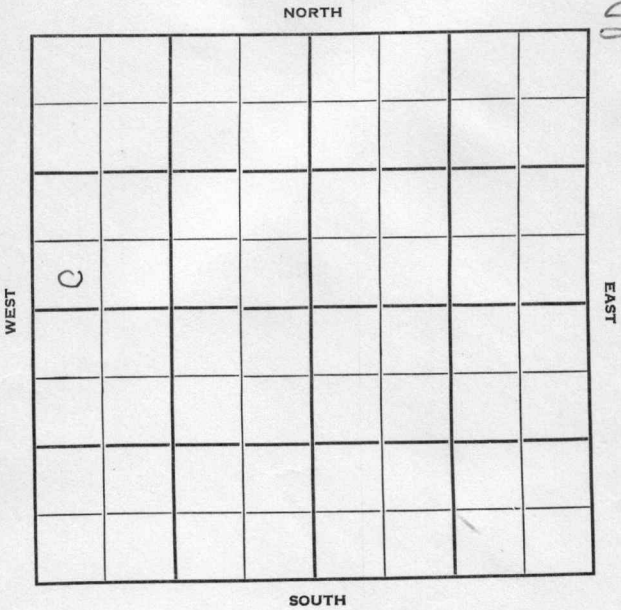

Sec. 22 Twp. 14 R. 13 W

Well No. # 2 Jones (B) Farm

Duke & Wood Company

Duke & Wood Contractor
Hall Gurney


Ft. from N. Line

330 Ft. from S. Line

Ft. from E. Line

330 Ft. from W. Line

SW SW NW

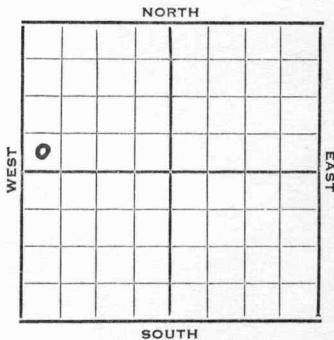

1952 Elev. 1780' REPORT

9/10 8" @ 253' Anhy 717'
Drlg. 1517'

9/17 Tarkio 2282' RTD 2318' 4" @ 2318'

9/24 NR

10/1 CO 2309' 15/2297-99' 3M gas RP 800
Killed well. Sd-frac.

10/8 "

10/15 "

10/22 Gas Well
TD 2318'
8" @ 253'
Anhy 717', Tarkio 2282',
TD 2318'
4" @ 2318'
CO to 2309'
15/2297-99 3 mcfg sd-frac
Comp. 3 mcfgpd

COMPLETED

County Russell State Kansas

Sec. 22 (Blk. 14 Twp.) (Sur. 13W Rge.) Map No.

Operator Duke & Wood

Well No. 2 Farm Jones "B"

Elev. 1780 Location SW SNNW

0							
COMPLETE							

330 Ft. From S Line NW

330 Ft. From W Line Quarter

1st. Report

Completion OCT 22 1952

Remarks Hall-Gurney Pool
Duke & Wood - Contr.

Spudding Date

Drig. Data Gas well TD 2318

8" @ 253 Anhy 717 Tarkio 2282

TD 2318 4" @ 2318 CO to 2309

15/ 2297-99 3 mcfg sd-frac

Comp. 3 mcfgpd

