

KANSAS

Form 51-5M-7-39-Palace


Barton

Section 1 Township 16 Range 14-W

Well No. #7 Ehrlich "B."

Company Shell

NORTH Trapp Pool

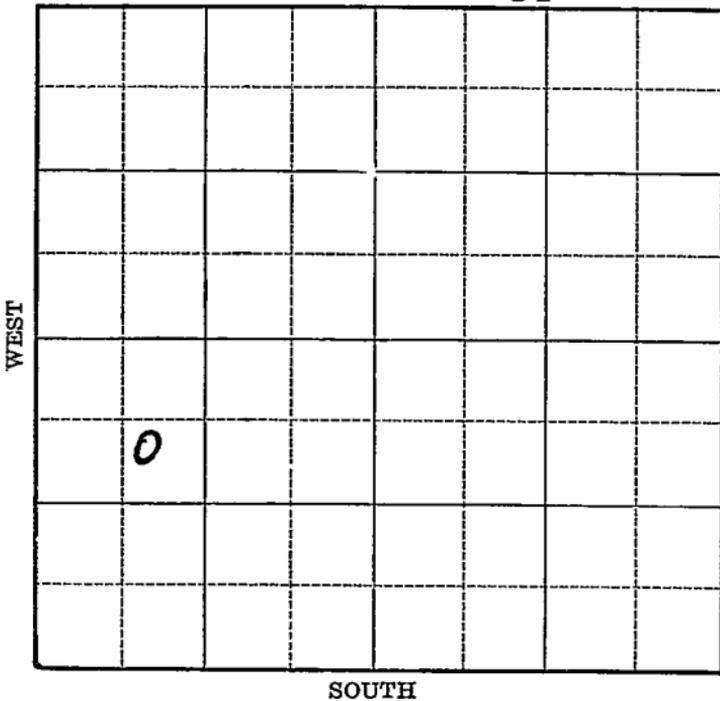

12

Sec. 1 Twp. 16 R. 14-W

Well No. #7 Ehrlich "B" Farm

Shell Company


(Trapp)

826 Ft. from N. Line

Ft. from S. Line

Ft. from E. Line

823 Ft. from W. Line

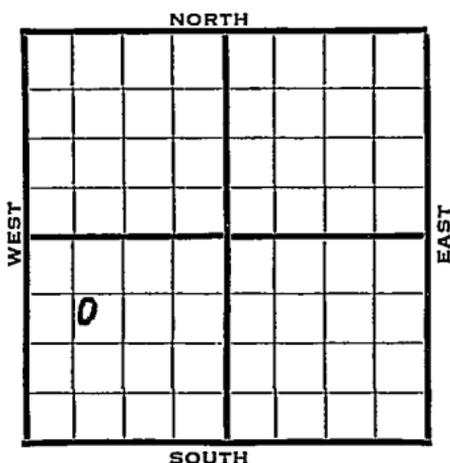

Elev. 1879

1940	REPORT
5/1	Spud.
5/9	8" - 625'
	Drlg. 2040'
5/16	Drlg. 3102'
5/23	Topeka 2780' Lans. 3100'
	Arb. 3296' Drlg. 3300'
	4" - 3297' 600' oil.
5/29	T.D. 3306' Swab 252 oil & 16 water 6 hours.
6/6	" " "
6/12	Arb. 3296'
	4" - 3297'
	T.D. 3306'
	2000 acid.
	Pump 146 oil & 78 water.
	COMPLETED

Map No. 73 Sec. 1 Twp. 16 R. 14W

Well No. 7 Ehrlich "B"
Shell

Company

Contractor

FIRST REPORT

SE NW SW

826 Ft. from N. Line

_____ Ft. from S. Line

_____ Ft. from E. Line

823 Ft. from W. Line

SECTION PLAT

TRAPP POOL

Location _____

Rig up _____

Drilling and Remarks:

Spud

RECORD

Cased _____ in., _____ ft.

Sand _____

Gas _____

Oil _____

Total Depth _____

PRODUCTION

1st 24 hrs. Nat. _____

1st 24 hrs. after shot _____

Gas _____ Cu. Ft.

Dry Hole _____

Abandoned _____

Date

MAY 1 1940 19

S. J. LEWIS Scout

Map No. 73 Sec. 1 Twp. 16 R. 14WWell No. 7 Ehrlich "B"

Shell

Company

Contractor

COMPLETED

SE NW SW

826 Ft. from N. Line

_____ Ft. from S. Line

_____ Ft. from E. Line

823 Ft. from W. Line

TRAPP POOL

SECTION PLAT

	o		
			.

Location _____

Rig up _____

Drilling and Remarks:

*Cor & 3296**4" @ 3297**2000 cuil**Pump. 146 cuil**58 Water.*

RECORD

Cased _____ in., _____ ft.

Sand _____

Gas _____

Oil _____

Total Depth 3306

PRODUCTION

1st 24 hrs. Nat _____

1st 24 hrs. after shot _____

Gas _____ Cu. Ft.

Dry Hole _____

Abandoned _____

Date

JUN 12 1940 19

S. J. LEWIS Scout