


Section 3 Township 16 Range 3 W

Well No. # 4 Martin

Company Currier & Keyes

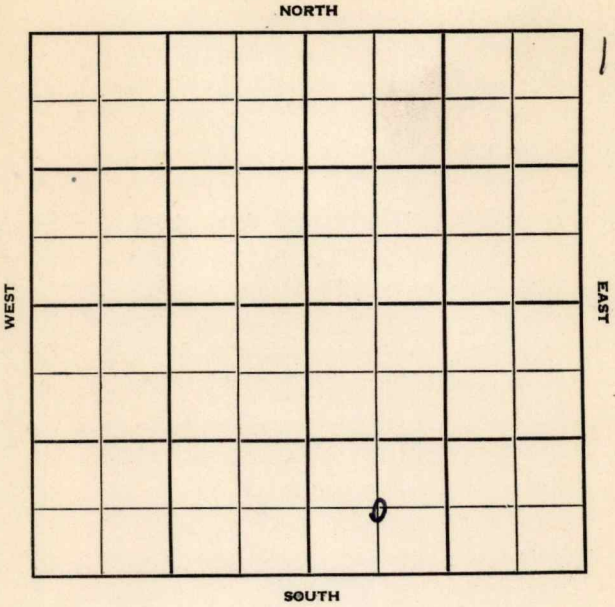

Saline

KANSAS ✓

Sec. 3 Twp. 16 R. 3W

Well No. #4 Martin Farm

Currier & Keyes Company

Contractor

Olsson Pool


Ft. from N. Line

660 Ft. from S. Line

Ft. from E. Line

660 Ft. from W. Line

C SW SE

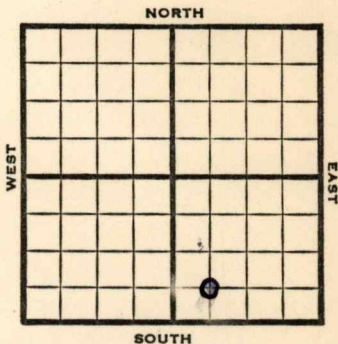

1953

Elev. 1306' REPORT

5/20
5/28

Location
8" @ 325'

6/3

Miss 2811'
Drlg 2841'

6/10

Mg. sho 3218, Mg Dol 3277 SO 3277-97
V 3334
S.O. 3348-57 RTD 3470
5" @ 3470'

6/24

Spud 5-23-53 Oil well TD 3482
8" @ 325 Miss 2811 Maq. sh. 3218'
Maq. dol. 3277 SO 3277-97
Viola 3334 SO 3348-57 TD 3470
5" @ 3470 DD 3482 Simp. 3474
HFW PB 3470 18/3380-83 42/3347-56
B/SSO & 2 BW 10 hr. SP 3296
35/3275-83 VSSO 1500 A FU 430' oil
600' wtr. 16 hr.
Comp. 30 BOPD 10% wtr.

COMPLETED

County Saline State Kansas
 Sec. 3 (Blk. 16 (Sur. Rge.) 3W Map No.
 Operator Currier & Keyes
 Well No. 4 Farm Martin
 Elev. 1306 Location C SW SE

660 Ft. From S Line SE
 660 Ft. From W Line Quarter
 Ist. Report _____
 Completion JUN 24 1953
 Remarks Olsson Pool
 Spudding Date 5-23-53

Drig. Data Oil well TD 3482
8" @ 325 Miss. 2811 Maq. sh. 3218
Maq. dol. 3277 SO 3277-97 Viola 3334
SO 3348-57 TD 3470 5" @ 3470
DD 3482 Simp. 3474 HFW PB 3470
18/ 3380-83 42/ 3347-56 B/ SSO & 2 bw
10 hr. SP 3296 35/ 3275-83 VSSO
1500 A FU 430' oil 600' wtr. 16 hr.
Comp. 30 bopd 10% wtr.

County **Saline** State **Kansas**

Sec. **3** (Blk. Twp.) **16** (Sur. Rge.) **3W** Map No.

Operator **Currier & Keyes**

Well No. **4** Farm **Martin**

Elev. Location **C SW SE**

FIRST REPORT

660 Ft. From **S** Line **SE**

660 Ft. From **W** Line **Quarter**

1st. Report **MAY 20 1953**

Completion

Remarks

Spudding Date

Drig. Data **Olsson Pool**

Location

Lined area for additional notes or data.