


KANSAS

FORM 51 5M 10-41 PETROL

Section 1 Township Barton 16 Range 14-W

Well No. #9 Ehrlich "B"

Company Shell

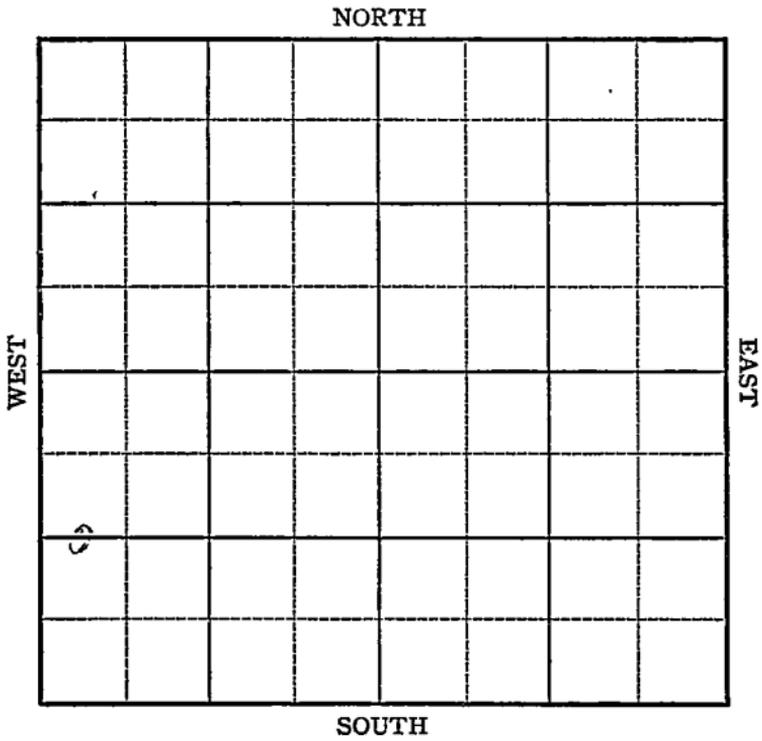

KANSAS

Barton

Sec. 1 Twp. 16 R. 14-W

Well No. #9 Ehrlich "B" Farm

Shell Company


(Trapp)

1320 Ft. from N. Line

_____ Ft. from S. Line

_____ Ft. from E. Line

330 Ft. from W. Line

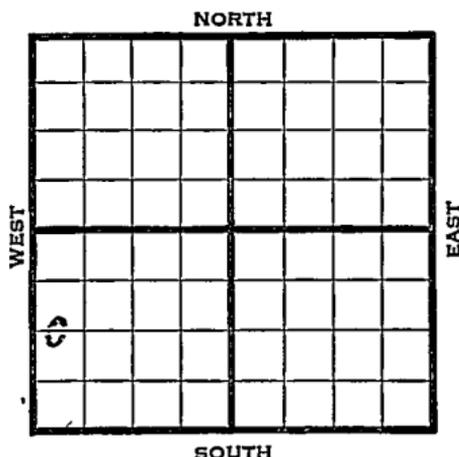

Elev. 1860

REPORT	
1941	
11/12	Cellar.
11/20	8" - 613' Drlg. 1465'
11/26	Drlg. 2785'
12/4	Topeka 2752' Lans. 3065'
	Arb. 3270' 4" - 3271' RUST.
1941	
12/11	TD 3285-6000 aci'd swb.
	336 oil in 7 hrs.
12/18	Swb. 047 oil in 15 hrs.
12/23	Arb. 3270'
	4" - 3271'
	T.D. 3285'
	8000 acid.
	Echometer potential 1272 bbls.
	39. Gravity
	COMPLETED

Map No. R 23 Sec. 1 Twp. 16 R. 14W

Well No. 9 Ehrlich "B"

Shell Company

FIRST REPORT Contractor

C WL SW


1320 Ft. from N. Line

_____ Ft. from S. Line

_____ Ft. from E. Line

330 Ft. from W. Line

SECTION PLAT

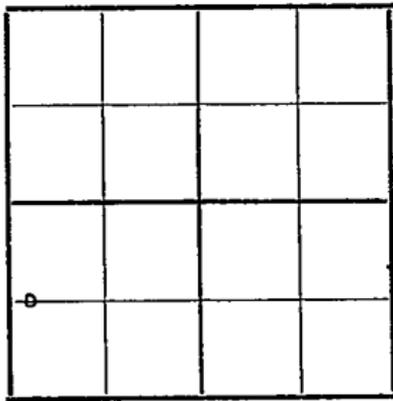

TRAPP POOL

Location _____

Rig up _____

Drilling and Remarks:

Cellar

RECORD

Cased _____ in., _____ ft.

Sand _____

Gas _____

Oil _____

Total Depth _____

PRODUCTION

1st 24 hrs. Nat. _____

1st 24 hrs. after shot _____

Gas _____ Cu. Ft.

Dry Hole _____

Abandoned _____

Date

NOV 12 1941

S. J. LEWIS Scout

Map No. 73 Sec. 1 Twp. 16 R. 14W

Well No. 9 Ehrlich "B"

Shell Company

COMPLETED Contractor

C WL SW

SECTION PLAT

1320 Ft. from N. Line

_____ Ft. from S. Line

_____ Ft. from E. Line

330 Ft. from W. Line

TRAPP POOL

RECORD

Location _____

Cased _____ in., _____ ft.

Rig up _____

Sand _____

Drilling and Remarks:

Gas _____

Oil _____

Total Depth 3275

PRODUCTION

1st 24 hrs. Nat. _____

1st 24 hrs. after shot _____

Gas _____ Cu. Ft.

Dry Hole _____

Abandoned _____

Cor 3270
4" @ 3271
5000 cuil
Echrd 3272
39° SW

Date

DEC 23 1941

19

S. J. LEWIS Scout