


Section 22 Township 14 Range 13 W

Well No. # 4 Jones "A"

Company Duke & Wood

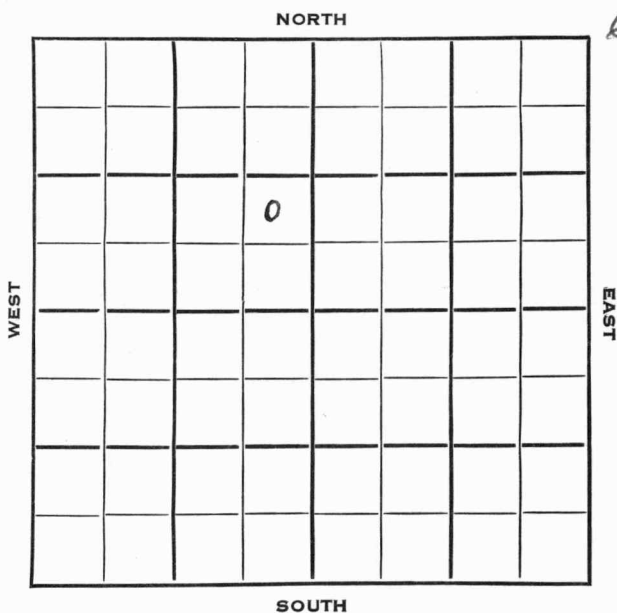

Sec. 22 Twp. 14 R. 13 W

Well No. # 4 Jones "A" Farm

Duke & Wood Company

Contractor

Hall-Gurney Pool


Ft. from N. Line

990 Ft. from S. Line

330 Ft. from E. Line

Ft. from W. Line

NE SE NW

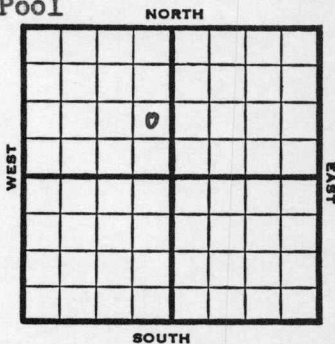

1953

Elev. 1732' REPORT

8/26

Spud 8-20-53

8" @ 232

Drlg. 1859'

9/2

Anhy 671', Tarkio 2250

RTD 2290'

5" @ 2289'

9/9

NR

9/16

NR

9/23

Spud 8-20-53

Oil Well

TD 2290'

8" @ 232'

Anhy 671', Tarkio 2250'

TD 2290'

5" @ 2289'

CO to 2270', 24/2251-55,

sd-oil-frac, S/1 boph

Comp. 25 bopd

COMPLETED



County Russell State Kansas

Sec. 22 (Blk. 14) (Sur. 13W) (Twp.) Map No.

Operator Duke & Wood

Well No. 4 Farm Jones "A"

Elev. 1732 Location NE SE NW

		o			
<b>COMPLETE</b>					

990Ft. From S Line NW

330Ft. From E Line Quarter

1st. Report

Completion SEP 23 1953

Remarks Hall-Gurney Pool

Spudding Date 8-20-53

Drlg. Data Oil well TD 2290

8" @ 232 Anhy 671 Tarkio 2250

TD 2290 5" @ 2289 CO to 2270

24/ 2251-55 sd-oil-frac S/ 1 boph

Comp. 25 bopd