

Section 22 ~~23~~ Township 14 Range 13 W

Well No. # 3 Jones "A"

Company Duke & Wood Drlg.

3

NORTH

		0					

WEST

EAST

SOUTH

Sec. 23-22 Twp. 14 R. 13W

Well No. #3 Jones "A" Farm

Duke & Wood Drlg. Company

Duke & Wood Contractor

Hall-Gurney Pool


330 Ft. from N. Line

_____ Ft. from S. Line

990 Ft. from E. Line

_____ Ft. from W. Line

NW NENW

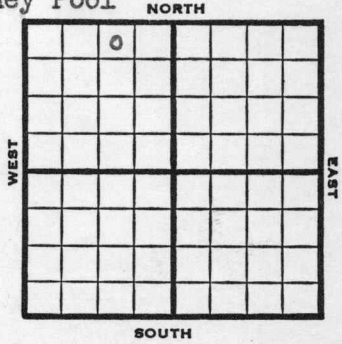

1953 ELEV. 1754' REPORT

5/27 Spud 5-21-53
8" @ 237'

5/28 Drlg 1920'
N.R.

6/3 Tarkio 2269'
RTD 2400'
5" @ 2400'

6/10 N.R.

6/24 Spud 5-21-53 Oil well TD 2400
8" @ 237 Tarkio 2269 TD 2400
5" @ 2400 27/2370-72 Perf 2280-84
Perf/2295-97 sd-frac. 2370-72
sd-frac 1 1/2 BOPH
Comp. 25 BOPD

COMPLETED

County Russell State Kansas

Sec. 23 (Blk. Twp.) 14 (Sur. Rge.) 13W Map No.

Operator Duke & Wood Drlg.

Well No. 3 Farm Jones "A"

Elev. _____ Location NW NE NW

		0				

330 Ft. From N Line NW

990 Ft. From E Line Quarter

1st. Report MAY 27 1953

Completion blue correction

Remarks this batch
Duke & Wood - Contr.

Spudding Date 5-21-53

Hall-Gurney Pool

Drlg. Data

8" @ 237 drlg. 1920

Nation

Map No. _____ Sec. 22 Twp. 14 R. 13W

Well No. 3 Jones "A"

Duke & Wood Company

CORRECTED

Contractor

NW NE NW

SECTION PLAT

~~_____~~
330 Ft. from N. Line

_____ Ft. from S. Line

990 Ft. from E. Line

_____ Ft. from W. Line

_____	0		

Russell County

Location Correct Section RECORD

Rig up _____

Drilling and Remarks:

Reported

23-14-13W

~~_____~~

Cased _____ in., _____ ft.

Sand _____

Gas _____

Oil _____

Total Depth _____

PRODUCTION

1st 24 hrs. Nat. _____

1st 24 hrs. after shot _____

Gas _____ Cu. Ft.

Dry Hole _____

Abandoned _____

Date

MAY 27 1959 19

J. G. McGEHEE

Scout

