

29-10-216
SEP

KANSAS

WELL COMPLETION REPORT AND DRILLER'S LOG

API No. 15 — 103 — 20088
County Number

S. 29 T. 10S R. 21 ^E/_W
Loc. C NE NE NW
County Leavenworth

Operator
Jennings Drilling Co.

Address
646 Louisiana Lawrence, Kansas 66044


Well No. # 1 Lease Name Hulbert

Footage Location
330 feet from (N) (S) line 330 feet from (E) (W) line

Principal Contractor PECO Drilling Co. Geologist Martin DuBois

Spud Date 5/26/81 Date Completed 6/2/81 Total Depth 1772 P.B.T.D. 1800

Directional Deviation none Oil and/or Gas Purchaser _____

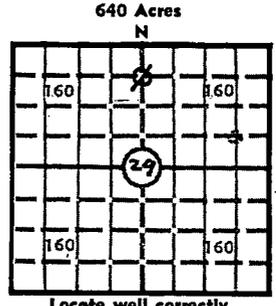

Elev.: Gr. 976
DF _____ KB _____

CASING RECORD

Report of all strings set — surface, intermediate, production, etc.

Purpose of string	Size hole drilled	Size casing set (in O.D.)	Weight lbs/ft.	Setting depth	Type cement	Sacks	Type and percent additives
Surface	9"	7"	14#	130*	Common	60	none
Production	6 1/4"	4 1/2"	9 1/2#	1,285	Common	50	none

LINER RECORD

PERFORATION RECORD

Top, ft.	Bottom, ft.	Sacks cement	Shots per ft.	Size & type	Depth interval
			3	11 grn	1223-1226

Size	Setting depth	Packer set at

ACID, FRACTURE, SHOT, CEMENT SQUEEZE RECORD

Amount and kind of material used	Depth interval treated

INITIAL PRODUCTION

Date of first production <u>July 7, 1981</u>	Producing method (flowing, pumping, gas lift, etc.) <u>Swabb</u>
RATE OF PRODUCTION PER 24 HOURS	Oil _____ bbls. Gas _____ MCF Water <u>2.2 BLSWPD</u> Gas-oil ratio <u>WISSIC</u> CFPB
Disposition of gas (vented, used on lease or sold)	Producing interval(s) <u>2-5 1981</u>

RECEIVED
STATE CORPORATION COMMISSION

CONSERVATION DIVISION
Wichita, Kansas

INSTRUCTIONS: As provided in KCC Rule 82-2-125, within 90 days after completion of a well, one completed copy of this Driller's Log shall be transmitted to the State Geological Survey of Kansas, 4150 Monroe Street, Wichita, Kansas 67209. Copies of this form are available from the Conservation Division, State Corporation Commission, 245 No. Water, Wichita, Kansas 67202. Phone AC 316-522-2206. If confidential custody is desired, please note Rule 82-2-125. Drillers Logs will be on open file in the Oil and Gas Division, State Geological Survey of Kansas, Lawrence, Kansas 66044.

Operator Jennings Drilling Co. DESIGNATE TYPE OF COMP.: OIL, GAS, DRY HOLE, SWDW, ETC.:

Well No. # 1 Lease Name Hulbert Dry Hole

S 29 T 10S R 21 E

WELL LOG

Show all important zones of porosity and contents thereof; cored intervals, and all drill-stem tests, including depth interval tested, cushion used, time tool open, flowing and shut-in pressures, and recoveries.

SHOW GEOLOGICAL MARKERS, LOGS RUN, OR OTHER DESCRIPTIVE INFORMATION.

FORMATION DESCRIPTION, CONTENTS, ETC.	TOP	BOTTOM	NAME	DEPTH
Lansing - Kansas City	70	555	Induction	surface total depth
Altamont	701	706	Density	
Squirrel Sand	872	915	Gamma Ray	
Bartlesville Sand	1030	1070	SP	
McLouth Sand	1218	1228	Neutron	
McLouth Sand	1325	1327		
Mississippi	1328	1660		
Kinderhook	1660	1722		
Hunton	1723	1772		

USE ADDITIONAL SHEETS, IF NECESSARY, TO COMPLETE WELL RECORD.

Date Received _____
 Signature: Kelley D. Lane
 Title: Drill Supervisor
 Date: 6/20/81

52-00-312