

O.W.W.O.

Summer

Section 35 Township 34 Range 2E


Well No. #1 Metzinger

Company Royal Oil
~~I.G. Smitheman~~

NORTH

WEST

EAST

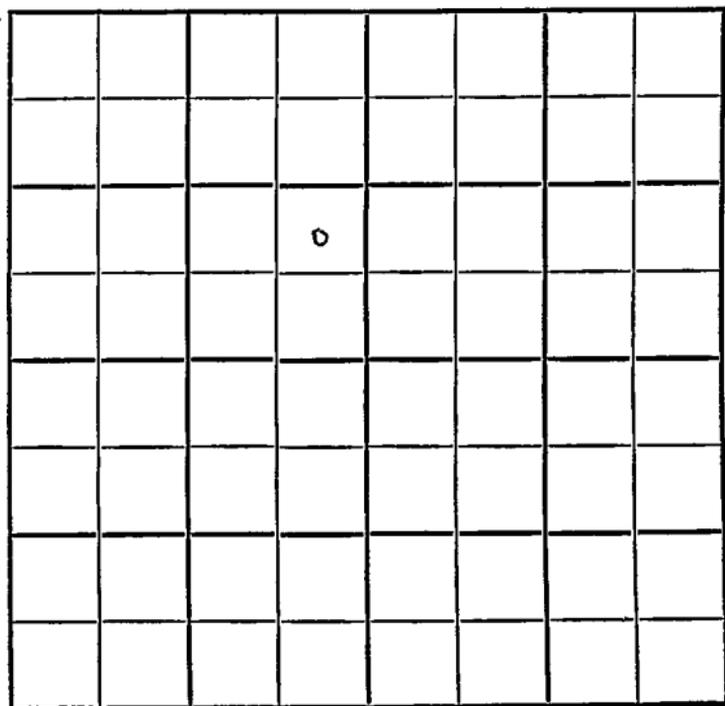

SOUTH

O.W.W.O.

Summer

KANSAS


SEC.	TWP.	R.
35	34	2 E

WELL NO. _____
 # 1 Metzinger FARM
 COMPANY

~~L. C. Smitherman~~ ROYAL OIL.
 CONTRACTOR

Uhl
 Padgett Pool

_____ Ft. from N. Line
 990 _____ Ft. from S. Line
 330 _____ Ft. from E. Line
 _____ Ft. from W. Line

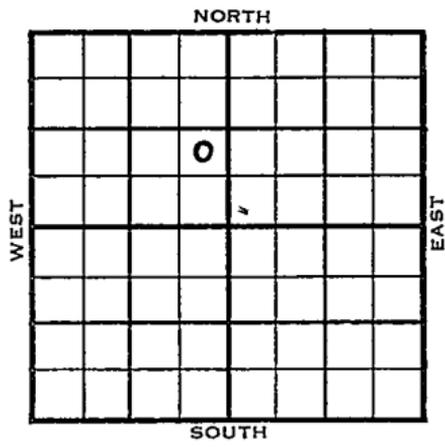

NE SE NW

	ELEVATION	REPORT
1955	1198 1200'	

3/9 Spud 3-5-55
 8" @ 110
 Drlg. 1000'
 3/16 Spud 3-5-55, D&A TD 3505;
 8" @ 110, Stal 2340, Layton 2784
 KC 2990, B KC 3088, Cleve 3104,
 Big Lime 3176, Cherokee 3296,
 Bart 3475, Miss 3501, TD 3505
 D&A

ABANDONED
O.W.W.O.

1955
 3/23 Layton 2777' KC 2980' Cleve. 3101'
 Big Lime 3169' Miss 3491'
 OTD 3505'
 to set 5"

4/13 Oil well - TD 3505' Layton 2777',
 KC 2980', Cleve 3101', Big lime 3169'
 Miss 3491', OTD 3505' 5" @ 3160'
 CO 64/3108-20 frac 6,500,000 CFG
 4 1/2 BOPH F/4 to 5 BOPH 10,800,000
 CFG. Comp. 25 BOPD 7,800,000 gas

COMPLETED

County Sumner State Kansas

Sec. 35 (Blk. Twp.) 34 (Sur. Rge.) 2E Map No.

Operator L. C. Smitherman

Well No. 1 Farm Metzinger

Elev. _____ Location NE SE NW

		o			
FIRST REPORT					

990 Ft. From S Line NW c

330 Ft. From E Line Quarter

Ist. Report MAR 9 1955.

Completion _____

Remarks _____

Uhl - Contr.

Spudding Date 3-5-55

Drlg. Data Padgett Pool

8" @ 110 drlg. 1000

County Sumner State Kansas

Sec. 35 (Blk. 34 (Sur. 2E (Twp.) Rge.) Map No.

Operator Royal Oil (was Smitherman)

Well No. 1 Farm Metzinger

Elev. 1200 Location NE SE NW

990 Ft. From S Line NW

330 Ft. From E Line Quarter

1st. Report

Completion APR 13 1955

Remarks CWTC

Uhl - Contr.

Spudding Date

Drlg. Data Oil well TD 3505

Layton 2777 KC 2980 Cleve. 3101

Big lime 3169 Miss. 3491 OTD 3505

5" @ 3160 CO 64/ 3108-20 frac

6,500,000 cfg 4 1/2 boph F/ 4 to 5 boph

10,800,000 cfg Comp. 25 bopd 7,800,000 g

FABEN GILSTRAP