FORM 51 10M 8-47

KANSAS


Saline

Section 4 Township 16 Range 3W

Well No. 1 Lingstrom

Company ~~Sherman et al~~

Wildcat

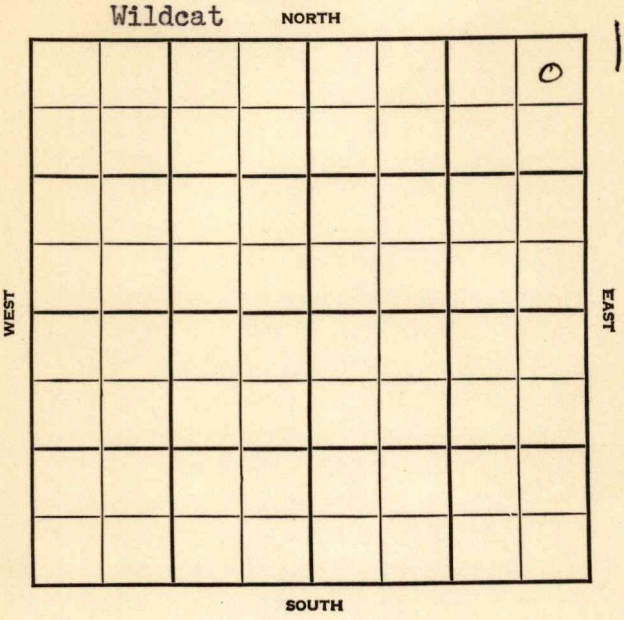

FORM 252-A
5M 9-47 PETROL

KANSAS Saline

Sec. 4 Twp. 16 R. 3-W

Well No. #1 Lingstrom Farm

Sherman et al Company

Wildcat


330' Ft. from N. Line

Ft. from S. Line

330' Ft. from E. Line

Ft. from W. Line

NE/C

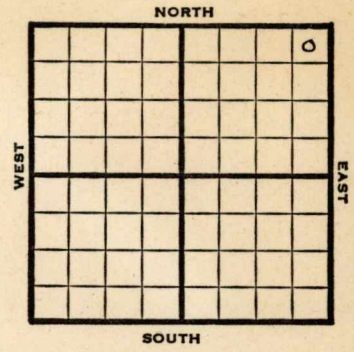


| 1947 | Elev. 1300' REPORT |
|---|---|
| 11/12 | Location |
| 11/19 | 8" @ 278'<br>Drlg. 2753' |
| 11/25 | Mississippi 2807'<br>Maquoketa 3291'<br>Drlg. 3347' |
| 12/3 | Viola 3347'<br>Simp Sd 3484'<br>Arbuckle 3505'<br>Total Depth 3535' |

ABANDONED

Form 26 200 Bks. 10-46 Petrol

Kansas

Wildcat

Map No. _____ Sec. 4 Twp. 16 R. 3W


Well No. 1 Lingstrom

Sherman etal. Company

FIRST REPORT Contractor

NE/C

SECTION PLAT

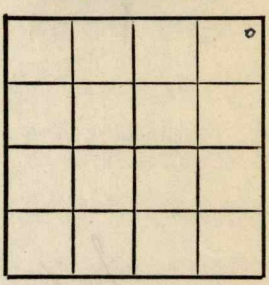

330 Ft. from N. Line

_____ Ft. from S. Line

330 Ft. from E. Line

_____ Ft. from W. Line

Saline County

Location _____

Rig up _____

Drilling and Remarks:

RECORD

Cased _____ in., _____ ft.

Sand _____

Gas _____

Oil _____

Total Depth _____

PRODUCTION

1st 24 hrs. Nat. _____

1st 24 hrs. after shot _____

Gas _____ Cu. Ft.

Dry Hole _____

Abandoned _____

Date

NOV 12 1947 19

S. J. LEWIS Scout

Form 26 200 Bks. 10-46 Petrol

Wildcat

Kansas

Map No. 42 Sec. 4 Twp. 16 R. 3W

Well No. 1 Lingstrom


Sherman etal. Company

ABANDONED Contractor

NE/C

Elev. 1300

**SECTION PLAT**

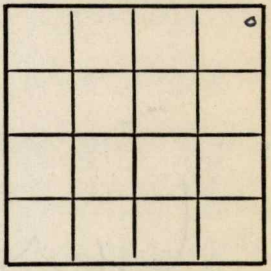

330 Ft. from N. Line

Ft. from S. Line

330 Ft. from E. Line

Ft. from W. Line

Saline County

Location

Rig up

Drilling and Remarks:

Kista 3347

Simp Sd 3484

TD 3535

**RECORD**

Cased in., ft.

Sand

Gas

Oil

Total Depth 3535

**PRODUCTION**

1st 24 hrs. Nat.

1st 24 hrs. after shot

Gas Cu. Ft.

Dry Hole

Abandoned

Date

DEC 3 1947

19 S. J. LEWIS Scout