Saline


FORM SC-5M PETROL

KANSAS

Section 4 Township 16 Range 8W

Well No. #1 Lofgren

Company Margay

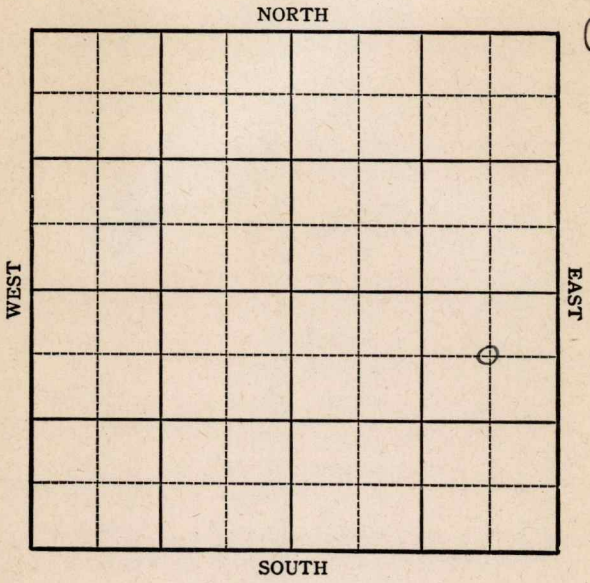

9

FORM 252-A
5M 9-43 GASS KANSAS

Saline

Sec. 4 Twp. 16 R. 3W

Well No. #1 Lofgren Farm

Margay Company


660 Ft. from N. Line

Ft. from S. Line

660 Ft. from E. Line

Ft. from W. Line

C NE SE Elev. 1294

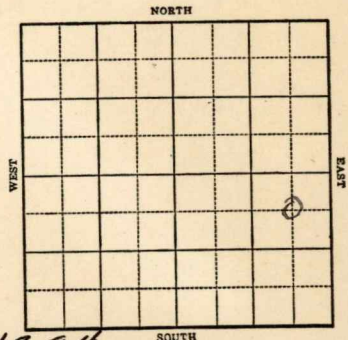

1944	REPORT
2/9	Cellar
2/15	"
2/23	Drlg. 2210 10" @ 325
3/1	Drlg. 3240'
3/8	Miss 2800 B. Miss 3040 Simp Sd 3475-80 TD SSO 5" @ 3475 Rust
3/16	TD 3496 PB 3383 48 shots 3350-62-2500 acid 2 bailers oil per hr.
3/22	Simp. 3475 5" @ 3475 TD 3496 Water

ABANDONED

Form 26 200 Bks 5-42 Petrol

Saline

KANSAS

Map No. 42 Sec. 4 Twp. 16 R. 3W


Well No. 1 Lofgren

Margay Company

FIRST REPORT Contractor

C NE SE

SECTION PLAT

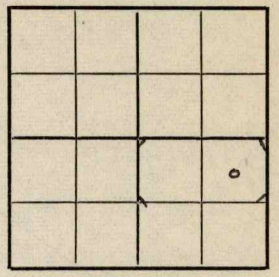

660 Ft. from N. Line

____ Ft. from S. Line

660 Ft. from E. Line

____ Ft. from W. Line

No Pool Name

Location

Rig up

Drilling and Remarks:

Cellar

RECORD

Cased ____ in., ____ ft.

Sand

Gas

Oil

Total Depth

PRODUCTION

1st 24 hrs. Nat.

1st 24 hrs. after shot

Gas ____ Cu. Ft.

Dry Hole

Abandoned

Date

FEB 9 1944 19

S. J. LEWIS Scout

Form 26 200 Bks 5-42 Petrol Saline

KANSAS

Map No. 42 Sec. 4 Twp. 16 R. 3W

Well No. 1 Lofgren

Morgey


Company

ABANDONED

Contractor

C NE SE

SECTION PLAT

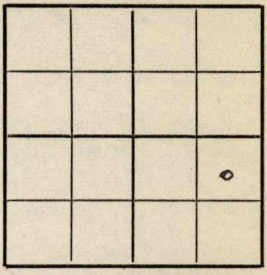

660 Ft. from N. Line

Ft. from S. Line

660 Ft. from E. Line

Ft. from W. Line

No Pool Name

Location

Rig up

Drilling and Remarks:

Surface 0 3475

3 - 0 3475

Water

RECORD

Cased in., ft.

Sand

Gas

Oil

Total Depth 3496

PRODUCTION

1st 24 hrs. Nat.

1st 24 hrs. after shot

Gas Cu. Ft.

Dry Hole

Abandoned

Date

MAR 2 2 1944 19

S. J. LEWIS Scout